

00111

LAND CORNER RECORDATION CERTIFICATE
Filing Requirement of Act 74, Mich. P.A. 1970
Isabella County Remonumentation

000217

For Corners in
Isabella

Table with columns: (County), Located In:, Corner Code#:
1. Public Land Survey T. 16N. R. 5W. A-6
2. Public Controlling in Section S. T. R.
3. Miscellaneous Property in Section S. T. R.
4. Lot No. Recorded Plat
5. Private Claims

9800000144
Filed for Record in
ISABELLA COUNTY, MI
SHARON A BROWN
On 01-06-1998 At 11:21:20 am.
RE LAND COR 9.00
Book OR Vol. 1 Pg. 217 - 217

Register of Deeds Stamp & File Number

I, Mark Robison, in a field survey on July, 1997, do hereby certify that under requirements of P.A. 74, Michigan P.A. of 1970, the corner points mentioned in lines 1 and 2 above were in conformance with regulations and rules therefore as required in the current manual of survey instructions of the United States Department of the Interior, Bureau of Land Management or by a decree of a Court of Law and/or that the corner points mentioned in lines 3, 4 and 5 above were in conformance with the rules of the Michigan Board of Land Surveyors or by a Decree of a Court of Law, established, re-established, monumented, re-monumented, recovered, found as expressed below.

NOTE: Not more than 2 corners, all in the same town and range, may be recorded on this certificate.

Grid table with columns A-M and rows 1-13 containing numbers 1-36.

A. Description of original monument and accessories and/or subsequent restoration:

1. G.L.O Original Survey

Township Lines: 2nd Quarter 1837 John Hodgson
Subdivision and Resurvey:
This is a common corner with M-6, T.16.N.-R.6W.
Page 506 Original Field Notes

2. County Survey Records:

Liber 3, Page 90, October 11, 1897, W. Trussell

3. L.C.R.C.


Liber 1, Page 335, April 21, 1975, Fluharty, Found 5/8" bar 10' North of fence to East and 25' South of Centerline road to East

4. Surveys of Record

None

5. Unrecorded Survey

Mears Engineering files, witness notes and field drawing

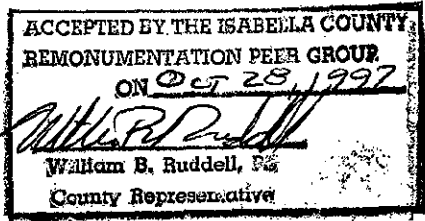

SURVEY &
REMONUMENTATION

MAR 09 1998

B. Description of corner evidence found and/or method applied in restoring or re-establishing corner:

This corner established in Isabella County Remonumentation Program. See dossier for detailed report.
Found iron and Fluharty witnesses. Found remains of Pine stump S.89°W +/-, 86.5' +/- per CSR.
Measured South 2657.43' to A-7 (CSR 2643.96')
Measured North 2650.54 to A-5 (CSR 2634.72')

SECTION

Accepted as best available evidence of the position of the original corner and replaced with Standard Monument Corner.

C. Description of monument for corner and accessories established to perpetuate locating the position of the corner:

Set Standard Isabella County Monument in Monument Box.

- A-6
N.45°W. 59.60' Nail & tag in 20" Poplar
S.60°W. 50.23' Nail & tag in 8" Oak
N.80°E. 42.30' Nail & tag in 36" Oak stump 12" high
S.30°E. 62.03' Nail & tag in 16" Oak



Signed by Mark Robison
Surveyor's Michigan License No. 27458

Date 12-30-97