

MAR 09 1998

LAND CORNER RECORDATION CERTIFICATE

Filing Requirement of Act 74, Michigan P.A. of 1970

SECTION

For Corners in
Isabella

(County)

Located In:

Corner Code#:

9800001903
FILED FOR RECORD IN
ISABELLA COUNTY, MI
SHARON A BROWN
On 02-27-1998 At 03:37:48 pm.
RE LAND COR 9.00
Book OR Vol. 1 Pg. 225 - 225

- 1. Public Land Survey T. 16 N.R. 5W. B-1
T. 17N R. 5W B-13 ClearCo
T. _____ R. _____
- 2. Public Controlling S. _____ T. _____ R. _____
in Section S. _____ T. _____ R. _____
- 3. Miscellaneous S. _____ T. _____ R. _____
Property in Section S. _____ T. _____ R. _____
- 4. Lot No. _____, Recorded Plat _____
- 5. Private Claims _____

Register of Deeds Stamp & File Number


I, Mark Robison, in a field survey on October 2, 1997, do hereby certify that under requirements of P.A. 74, Michigan P.A. of 1970, the corner points mentioned in lines 1 and 2 above were in conformance with regulations and rules therefore as required in the current manual of survey instructions of the United States Department of the Interior, Bureau of Land Management or by a decree of a Court of Law and/or that the corner points mentioned in lines 3, 4 and 5 above were in conformance with the rules of the Michigan Board of Land Surveyors or by a Decree of a Court of Law, established, re-established, monumented, re-monumented, recovered, found as expressed below.

	A	B	C	D	E	F	G	H	I	J	K	L	M
1													
2	6	5	4	3	2	1							
3													
4	7	8	9	10	11	12							
5													
6	18	17	16	15	14	13							
7													
8	19	20	21	22	23	24							
9													
10	30	29	28	27	26	25							
11													
12	31	32	33	34	35	36							
13													

NOTE: Not more than 2 corners, all in the same town and range, may be recorded on this certificate.

A. Description of original monument and accessories and/or subsequent restoration:

- 1. Original G.L.O. Survey:
Township Lines: 2nd Quarter by John Hodgson, 1837
Pages 486 & 508 Original Field Notes
Subdivision & Re-survey: 4th Quarter by Henry Nicholson, 1837
Pages 510 & 570
- 2. County Survey of Records:
None Found
- 3. L.C.R.C.
None Found
- 4. Surveys of Record:
None Found
- 5. Unrecorded Surveys:
Paul B. Lapham & Associates, Certificate of Survey Set 1/2" Capped iron Witnesses Noted

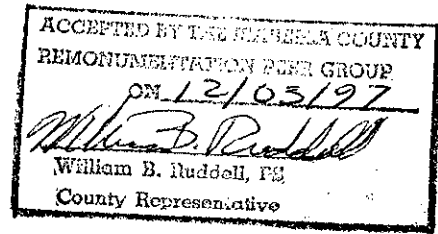

B. Description of corner evidence found and/or method applied in restoring or re-establishing corner:


This corner established in Isabella County Remonumentation Program. See dossier for detailed report.
-Found 1/2" x 18" capped iron and 1977 witnesses. Checked measurement West to A-1. Also checked measurement East and found that B-1 is on single proportion measurement between A-1 & C-1.

Accepted as best available evidence of the position of the original corner and replaced with Standard Monument.

C. Description of monument for corner and accessories established to perpetuate locating the position of the corner:

Set Standard Isabella County Monument in a Monument Box marked PS 27458.

- S49°W 63.34' Nail & Tag in 8" Maple
- S29°E 74.25' Nail & Tag in 15" Maple
- N01°E 39.24' Nail & Tag in 22" Twin Red Oak
- S80°W 94.30' Nail & Tag in Power Pole

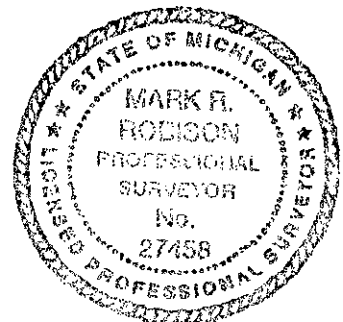

Signed by Mark Robison

Date 2-26-98

Surveyor's Michigan License No. 27458