

MAR 09 1998

LAND CORNER RECORDATION CERTIFICATE SECTION  
Filing Requirement of Act 74, Mich. P.A. 1970

For Corners in  
Isabella

(County)

Located In:

Corner Code#:

- 1. Public Land Survey T. 16 N.R. 5W. C-1  
T. 17N R. 5W C-13 Clare Co.  
T. \_\_\_\_\_ R. \_\_\_\_\_
- 2. Public Controlling S. \_\_\_\_\_ T. \_\_\_\_\_ R. \_\_\_\_\_  
in Section S. \_\_\_\_\_ T. \_\_\_\_\_ R. \_\_\_\_\_
- 3. Miscellancous S. \_\_\_\_\_ T. \_\_\_\_\_ R. \_\_\_\_\_  
Property in Section S. \_\_\_\_\_ T. \_\_\_\_\_ R. \_\_\_\_\_
- 4. Lot No. \_\_\_\_\_, Recorded Plat \_\_\_\_\_
- 5. Private Claims \_\_\_\_\_

9800001904  
Filed for Record in  
ISABELLA COUNTY, MI  
SHARON A BROWN  
On 02-27-1998 At 03:37:51 pm.  
RE LAND COR 9.00  
Book OR Vol. 1 Pg. 226 - 226

Register of Deeds Stamp & File Number


I, Mark Robison, in a field survey on October 2, 1997, do hereby certify that under requirements of P.A. 74, Michigan P.A. of 1970, the corner points mentioned in lines 1 and 2 above were in conformance with regulations and rules therefore as required in the current manual of survey instructions of the United States Department of the Interior, Bureau of Land Management or by a decree of a Court of Law and/or that the corner points mentioned in lines 3, 4 and 5 above were in conformance with the rules of the Michigan Board of Land Surveyors or by a Decree of a Court of Law, established, re-established, monumented, re-monumented, recovered, found as expressed below.

NOTE: Not more than 2 corners, all in the same town and range, may be recorded on this certificate.

	A	B	C	D	E	F	G	H	I	J	K	L	M
1													
2	6	5	4	3	2	1							
3													
4	7	8	9	10	11	12							
5													
6	18	17	16	15	14	13							
7													
8	19	20	21	22	23	24							
9													
10	30	29	28	27	26	25							
11													
12	31	32	33	34	35	36							
13													

A. Description of original monument and accessories and/or subsequent restoration:

- 1. Original G.L.O. Survey:  
Township Lines: 2<sup>nd</sup> Quarter by John Hodgson, 1837  
Pages 486 & 508  
Subdivision & Re-survey: 4<sup>th</sup> Quarter by Henry Nicholson, 1837  
Pages 510 & 570  
Subsequent Re-survey: Mr. Burt, 1850
- 2. County Survey of Records:  
Liber 6, Pages 31 & 32 Dated 1900 Clare County Surveyor
- 3. L.C.R.C.  
Liber 3, Page 990 Found Capped iron
- 4. Surveys of Record:  
None Found
- 5. Unrecorded Surveys:  
Paul B. Lapham & Associates, Certificate of Survey Found 1/2" Capped iron Witnesses Noted  
J. Sedgman Field Notes

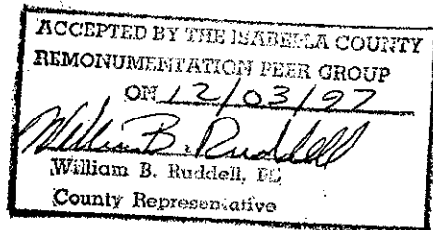


B. Description of corner evidence found and/or method applied in restoring or re-establishing corner:  
This corner established in Isabella County Remonumentation Program. See dossier for detailed report.

-Old Corner (Standard Corner) was used by Burt as common corner with T.17N.-R.5W. Distance West to A-1 is common to both townships. C.S.R. pine stub to N.E. cannot be conclusively identified. Sedgman either misread C.S.R. notes or noted a wrong bearing in his notes. Corner fits Laphams witnesses.

Accepted as best available evidence of the position of the original corner and replaced with Standard Monument.

C. Description of monument for corner and accessories established to perpetuate locating the position of the corner:  
Set Standard Isabella County Monument in a Monument Box marked PS 27458.

- N34°E 46.30' Nail & Tag in Corner Fence Post
- S60°W 33.35' Top center of telephone riser
- S42°E 28.68' Nail & Tag in Corner fence post
- N44°W 79.46' Nail & Tag in 13" White Pine

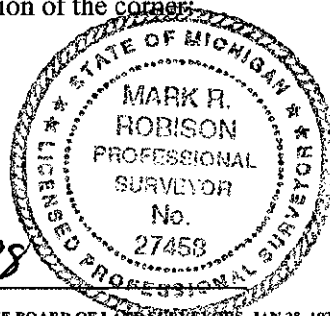

Signed by Mark R. Robison

Date 2-26-98

Surveyor's Michigan License No. 27458