

LAND CORNER RECORDATION CERTIFICATE
Filing Requirement of Act 74, Mich. P.A. 1970
Isabella County Remonumentation

JAN 25 2000

For Corners in
Isabella

SECTION

(County)	Located In:	Corner Code#:
1. Public Land Survey	T. <u>16N</u> R. <u>5W</u>	<u>C-3</u>
	T. _____ R. _____	_____
	T. _____ R. _____	_____
2. Public Controlling in Section	S. _____ T. _____ R. _____	_____
	S. _____ T. _____ R. _____	_____
3. Miscellaneous Property in Section	S. _____ T. _____ R. _____	_____
	S. _____ T. _____ R. _____	_____
4. Lot No. _____, Recorded Plat _____		
5. Private Claims _____		

99900012539
 Filed for Record in
 ISABELLA COUNTY, MI
 SHARON A BROWN
 On 12-16-1999 At 08:33:10 am.
 RE LAND COR 9.00
 Liber 1 Page 318 - 318

Register of Deeds Stamp & File Number


I, Jan S. Fokens, in a field survey on November 23, 1999, do hereby certify that under requirements of P.A. 74, Michigan P.A. of 1970, the corner points mentioned in lines 1 and 2 above were in conformance with regulations and rules therefore as required in the current manual of survey instructions of the United States Department of the Interior, Bureau of Land Management or by a decree of a Court of Law and/or that the corner points mentioned in lines 3, 4 and 5 above were in conformance with the rules of the Michigan Board of Land Surveyors or by a Decree of a Court of Law, established, re-established, monumented, re-monumented, recovered, found as expressed below.

	A	B	C	D	E	F	G	H	I	J	K	L	M
2	6	5	4	3	2	1							
3		•											
4	7	8	9	10	11	12							
5													
6	18	17	16	15	14	13							
7													
8	19	20	21	22	23	24							
9													
10	30	29	28	27	26	25							
11													
12	31	32	33	34	35	36							
13													

NOTE: Not more than 2 corners, all in the same town and range, may be recorded on this certificate.

A. Description of original monument and accessories and/or subsequent restoration:

- G.L.O Original Survey
 Township: John Hodgson May, 1837
 Subdivision: Henry Nicholson October, 1837
 Pages 508, 564, 566, 570 original field notes
- County Survey Records:
 Liber 4, Page 142 C.H. Freeman April 1920 Set iron pipe w/ stone
- L.C.R.C.:
 Liber 3, Page 936 Thomas Mueller July 29, 1988 Found bent 1/2" rod
- Surveys of Record:
 Liber 001, Page 34 Distances noted to other corners
- Unrecorded Survey:
 None Available

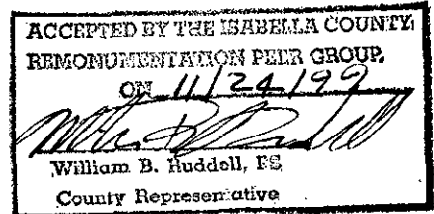

B. Description of corner evidence found and/or method applied in restoring or re-establishing corner:
 This corner established in Isabella County Remonumentation Program. See dossier for detailed report.
 This is an existent corner.


- Found 1/2" re-rod
- Excavated to 3.5'. Found no further evidence

Accepted as the best available evidence of the position of the accepted corner and replaced with Standard Monument Corner.

C. Description of monument for corner and accessories established to perpetuate locating the position of the corner:
 Set Standard Isabella County Monument in Monument Box, stamped C-3 and PS 21567.

- C-3 SW. Corner, Section 5, T.16N.-R.5W., Gilmore Twp., Isabella Co, MI**
- N.52°E. 62.64' Set LSC nail and cap in S. side of power pole
 - N.41°W. 82.04' Found nail and cap in E. face of 8" Red pine
 - S.45°W. 39.03' Found nail and cap in E. face of stub pole
 - S.35°E. 40.45' Found nail and cap in W. face of fence post
 - N.89°47'36"E. 2646.87' (D-3) S. 1/4 Corner, Section 5, T.16N.-R.3W., Gilmore Twp., Isabella Co., MI.
 - N.02°08'31"W. 2648.13' (C-2) W. 1/4 Corner, Section 5, T.16N.-R.3W., Gilmore Twp., Isabella Co., MI.

Signed by _____
 Surveyor's Michigan License No. 21567

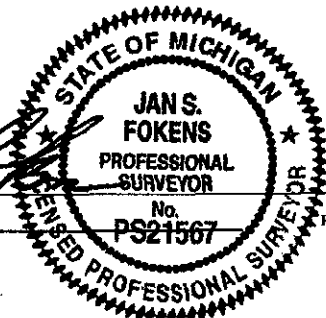

Date 12/14/99