

LAND CORNER RECORDATION CERTIFICATE
 Filing Requirement of Act 74, Mich. P.A. 1970
 Isabella County Remonumentation

MAR 09 1998

001-19

SECTION

For Corners in
Isabella

000222

(County)	Located In:	Corner Code#:
1. Public Land Survey	T. <u>16N.</u> R. <u>5W.</u>	<u>C-6</u>
	T. _____ R. _____	_____
	T. _____ R. _____	_____
2. Public Controlling in Section	S. _____ T. _____ R. _____	_____
	S. _____ T. _____ R. _____	_____
3. Miscellaneous Property in Section	S. _____ T. _____ R. _____	_____
	S. _____ T. _____ R. _____	_____
4. Lot No. _____, Recorded Plat _____		
5. Private Claims		

9800000149
 Filed for Record in
 ISABELLA COUNTY, MI
 SHARON A BROWN
 On 01-06-1998 At 11:21:40 am.
 RE LAND COR 9.00
 Book OR Vol. 1 Pg. 222 - 222

Register of Deeds Stamp & File Number

I, Mark Robison, in a field survey on July, 1997, do hereby certify that under requirements of P.A. 74, Michigan P.A. of 1970, the corner points mentioned in lines 1 and 2 above were in conformance with regulations and rules therefore as required in the current manual of survey instructions of the United States Department of the Interior, Bureau of Land Management or by a decree of a Court of Law and/or that the corner points mentioned in lines 3, 4 and 5 above were in conformance with the rules of the Michigan Board of Land Surveyors or by a Decree of a Court of Law, established, re-established, monumented, re-monumented, recovered, found as expressed below.

NOTE: Not more than 2 corners, all in the same town and range, may be recorded on this certificate.

	A	B	C	D	E	F	G	H	I	J	K	L	M
2	6	5	4	3	2	1							
3													
4	7	8	9	10	11	12							
5													
6	18	17	16	15	14	13							
7													
8	19	20	21	22	23	24							
9													
10	30	29	28	27	26	25							
11													
12	31	32	33	34	35	36							
13													

A. Description of original monument and accessories and/or subsequent restoration:


1. G.L.O Original Survey
 Township Lines: 2nd Quarter 1837 John Hodgson
 Subdivision and Resurvey: 4th Quarter 1837 H. Nicholson.
 Page 560 Original Field Notes

2. County Survey Records:
 None

3. L.C.R.C.
 None

4. Surveys of Record
 Liber 2, Page 38, Fluharty Eng., April 21, 1975, Found wood post, set 5/8" x 18" rebar & RLS cap at Meander corner.

5. Unrecorded Survey
 None

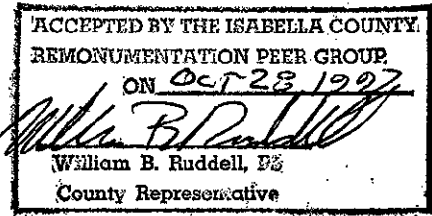

B. Description of corner evidence found and/or method applied in restoring or re-establishing corner:

This corner established in Isabella County Remonumentation Program. See dossier for detailed report.

Found 4" wood post 134' North (G.L.O.=132') of meander corner on shoreline. Post was used by Fluharty in 1975 as meander corner.

Accepted as best available evidence of the position of the original corner and replaced with Standard Monument Corner.

C. Description of monument for corner and accessories established to perpetuate locating the position of the corner:

Set Standard Isabella County Monument.

- N.40°E. 74.05' Nail & tag in 7" Tamarack
- S.08°W. 122.41' Nail & tag in twin Cedar at Lake
- S.46°W. 88.71' Nail & tag in 5" Spruce
- N.14°W. 91.67' Nail & tag in 16" Tamarack
- S.02°E. 134.80' Meander Corner



Signed by Mark R. Robison

Date 12-30-97

Surveyor's Michigan License No. 27458