

LAND CORNER RECORDATION CERTIFICATE

MAR 09 1998

Filing Requirement of Act 74, Mich. P.A. 1970

Isabella County Remonumentation

SECTION

00150

000223

For Corners in Isabella

Table with columns: (County), Located In, Corner Code#. Rows include Public Land Survey, Public Controlling in Section, Miscellaneous Property in Section, Lot No., and Private Claims.

9800000150 Filed for Record in ISABELLA COUNTY, MI SHARON A BROWN On 01-06-1998 At 11:21:45 am. RE LAND COR 9.00 Book OR Vol. 1 Pg. 223 - 223

Register of Deeds Stamp & File Number


I, Mark Robison, in a field survey on July, 1997, do hereby certify that under requirements of P.A. 74, Michigan P.A. of 1970, the corner points mentioned in lines 1 and 2 above were in conformance with regulations and rules therefor as required in the current manual of survey instructions of the United States Department of the Interior, Bureau of Land Management or by a decree of a Court of Law and/or that the corner points mentioned in lines 3, 4 and 5 above were in conformance with the rules of the Michigan Board of Land Surveyors or by a Decree of a Court of Law, established, re-established, monumented, re-monumented, recovered, found as expressed below.

Grid table with columns A-M and rows 1-13. Contains numbers 1-36 in a grid pattern.

NOTE: Not more than 2 corners, all in the same town and range, may be recorded on this certificate.

A. Description of original monument and accessories and/or subsequent restoration:

- 1. G.L.O Original Survey: Township Lines: 2nd Quarter 1837 John Hodgson; Subdivision and Resurvey: 4th Quarter 1837 H. Nicholson; Page 558 Original Field Notes.
2. County Survey Records: Liber 3, Page 105, 1910, Trussell; Liber 4, Page 106, 1910, Trussell.
3. L.C.R.C.: Liber 1, Page 112, Courtright, July 23, 1974, 4" disc; Liber 1, Page 129, Lapham, December 28, 1972.
4. Surveys of Record: Liber 3, Page 124, Mears Engineering, June 16, 1979, Found 4" Concrete monument; Liber 3, Page 185, Fluharty, September 14, 1978, Found 4" Concrete monument.
5. Unrecorded Survey: Department of Conservation, Shadko, January, 1956, Found 1 1/4" Shaft, Set 4" Concrete Monument; Mears Engineering, Fluharty, November 30, 1977, Found 4" Concrete monument; Paul B. Lapham & Associates, Inc., October 190, 1988, Found 4" Concrete monument with brass cap; L.C.R.C. Section corner maps, Found 4" disc.

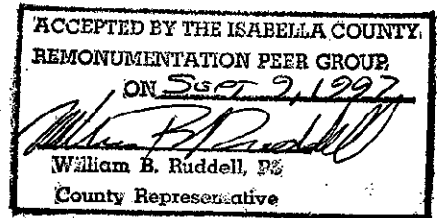


B. Description of corner evidence found and/or method applied in restoring or re-establishing corner: This corner established in Isabella County Remonumentation Program. See dossier for detailed report. Found 4" pipe filled with concrete and remains of brass cap anchor in center of pipe.

Accepted as best available evidence of the position of the original corner and replaced with Standard Monument Corner.

C. Description of monument for corner and accessories established to perpetuate locating the position of the corner: Accepted D.N.R. monument as Isabella County monument.

- S.29° W. 71.28' Nail & tag in power pole
N.37°E. 68.15' Nail & tag in power pole
N.12°E. 41.45' Nail & tag in 16" Pine
N.02°E. 43.95' Nail & tag in power pole

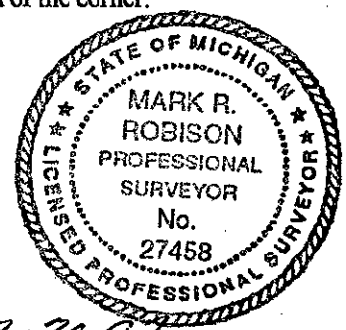

Signed by Mark R. Robison

Date 12-30-97

Surveyor's Michigan License No. 27458