

**LAND CORNER RECORDATION CERTIFICATE**  
**Filing Requirement of Act 74, Mich. P.A. 1970**  
**Isabella County Remonumentation**

JAN 25 2000

For Corners in  
Isabella  
 (County)

Located In: Corner Code#:

1. Public Land Survey T. 16N R. 5W E-3  
 T. \_\_\_\_\_ R. \_\_\_\_\_  
 T. \_\_\_\_\_ R. \_\_\_\_\_  
 2. Public Controlling S. \_\_\_\_\_ T. \_\_\_\_\_ R. \_\_\_\_\_  
 in Section S. \_\_\_\_\_ T. \_\_\_\_\_ R. \_\_\_\_\_  
 3. Miscellaneous S. \_\_\_\_\_ T. \_\_\_\_\_ R. \_\_\_\_\_  
 Property in Section S. \_\_\_\_\_ T. \_\_\_\_\_ R. \_\_\_\_\_  
 4. Lot No. \_\_\_\_\_, Recorded Plat \_\_\_\_\_  
 5. Private Claims \_\_\_\_\_

**SECTION**

199900012542  
 Filed for Record in  
 ISABELLA COUNTY, MI  
 SHARON A BROWN  
 On 12-16-1999 At 08:33:21 am.  
 RE LAND COR 9.00  
 Liber 1 Page 321 - 321

**Register of Deeds Stamp & File Number**


I, Jan S. Fokens, in a field survey on November 23, 1999, do hereby certify that under requirements of P.A. 74, Michigan P.A. of 1970, the corner points mentioned in lines 1 and 2 above were in conformance with regulations and rules therefore as required in the current manual of survey instructions of the United States Department of the Interior, Bureau of Land Management or by a decree of a Court of Law and/or that the corner points mentioned in lines 3, 4 and 5 above were in conformance with the rules of the Michigan Board of Land Surveyors or by a Decree of a Court of Law, established, re-established, monumented, re-monumented, recovered, found as expressed below.

**NOTE: Not more than 2 corners, all in the same town and range, may be recorded on this certificate.**

1	A	B	C	D	E	F	G	H	I	J	K	L	M
2	6	5	4	3	2	1							
3													
4	7	8	9	10	11	12							
5													
6	18	17	16	15	14	13							
7													
8	19	20	21	22	23	24							
9													
10	30	29	28	27	26	25							
11													
12	31	32	33	34	35	36							
13													

A. Description of original monument and accessories and/or subsequent restoration:

1. G.L.O Original Survey  
 Township: John Hodgson May, 1837  
 Subdivision: Henry Nicholson October, 1837  
 Pages 508, 550, 570 original field notes
2. County Survey Records:  
 Liber 4, Page 142 C.H. Freeman April, 1920 Distances noted
3. L.C.R.C.:  
 Liber 2, Page 709 Paul B. Lapham April 20, 1983 Found sucker rod
4. Surveys of Record:  
 Liber 003, Page 696 Found sucker rod  
 Liber 001, Page 34 Distances noted to other corners  
 Liber 004, Page 154 Found sucker rod
5. Unrecorded Survey:  
 None Available

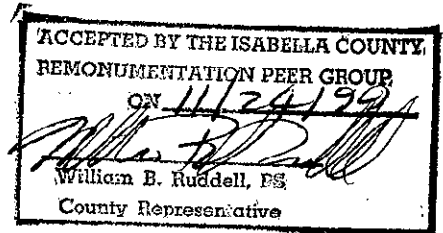

B. Description of corner evidence found and/or method applied in restoring or re-establishing corner:

- This corner established in Isabella County Remonumentation Program. See dossier for detailed report.  
 This is an existent corner.  
 1. Found 3/4" solid rod (sucker rod)  
 2. Excavated to 3.5'. Found no further evidence

Accepted as the best available evidence of the position of the accepted corner and replaced with Standard Monument Corner.

C. Description of monument for corner and accessories established to perpetuate locating the position of the corner:

Set Standard Isabella County Monument in Monument Box, stamped E-3 and PS 21567.

- E-3 SE. 1/4 Corner, Section 5, T.16N.-R.5W., Gilmore Twp., Isabella Co, MI**  
 N.23°W. 35.55' Found PK nail in E. face of a power pole 4' above the ground  
 S.35°E. 47.64' W. face of Stop sign leg  
 S.61°W. 62.13' Top center of telephone riser  
 N.24°E. 29.59' Found PK nail & flagging in E. face of fence corner post  
 N.00°53'19"W. 2631.94' (E-2) E. 1/4 Corner, Section 5, T.16N.-R.3W., Gilmore Twp., Isabella Co., MI.  
 S.90°00'00"W. 2649.01' (D-3) S. 1/4 Corner, Section 5, T.16N.-R.3W., Gilmore Twp., Isabella Co., MI.

Signed by Jan S. Fokens  
 Surveyor's Michigan License No. 21567

Date 12/14/99  
 FORM APPROVED BY MICHIGAN STATE BOARD OF LAND SURVEYORS, JAN.28, 1971  
 REVISED MAY 14, 1975  
 REVISED JAN., 1983