SURVEY & REMONUMENTATION
APR 2 9 1996
COMMISSION

REMONUMENTATION CORNER

LAND CORNER RECORDATION CERTIFICATE

Filing Requirement of Act 74, Mich. P.A. 1970

For corners in ISABELLA (County) Located In: Corner Code #

STATE OF MICHIGAN
COUNTY OF ISABELLA
RECEIVED FOR RECORD
DEC 11 10 38 AM '95
000084
SHARON A. BROWN
REGISTER OF DEEDS

Register of Deeds Stamp & File Number

1. Public Land Survey	T 16N R 5W	E-4
	T ___ R ___	
	T ___ R ___	
	T ___ R ___	
2. Property Controlling	S ___ T ___ R ___	
in Section	S ___ T ___ R ___	
3. Miscellaneous	S ___ T ___ R ___	
Property in Section	S ___ T ___ R ___	

4. Lot No. _____, Recorded Plat _____
5. Private Claims _____

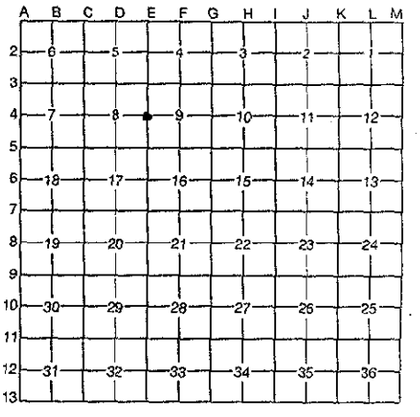

I, PAUL B. LAPHAM, *in a field survey on* OCTOBER, 19 95, do hereby certify that under requirements of P.A. 74, Michigan P.A. of 1970, the corner points mentioned in lines 1 and 2 above were in conformance with regulations and rules therefore as required in the current manual of survey instructions of the United States Department of the Interior, Bureau of Land *Management or by a decree of a Court of Law and/or that the corner points mentioned in lines 3, 4 and* 5 above were in conformance with the rules of the Michigan Board of Professional Surveyors or by a Decree of a Court of Law; established, re-established, monumented, re-monumented, recovered, found as expressed below:

NOTE: Not more than 4 corners, all in the same town and range, may be recorded *on this certificate.*

A. Description of original monument and accessories and/or subsequent restoration:

1837 NICHOLSON, G.L.O.

1850 BURT, G.L.O. RESURVEY
CORNER ON HEMLOCK 12" DIA.

1909 TRUSSELL, C.S.R. 4-88
CORNER IS A STONE 12x6x8 W.A. BURT
U.S. CORRECTION 1852. ONE O.B.T.
WITNESSES:(1)PINE 32 S14 1/2E 134 1/2 L
(2)PINE 33 N55°W 123 L

1920 FREEMAN, C.S.R. 4-142
GAS PIPE FOR CORNER STONE BESIDE
WITNESSES:(3)WHITE PINE SNAG N57E 77 LINKS
(4)ELM TREE 8" N16°W 126 LINKS

6-29-83 LAPHAM, (132) 4-175
FOUND 1/2" IRON & STONE
WITNESSES:(5)N70°E, 101.65' 12" PINE
(6)S45°E 47.30' 1/2" CAPPED RE-ROD
(7)S45°W 46.31' POWER POLE

6-29-83 LAPHAM, UNRECORDED SURVEY
SAME AS (132) 4-175 WITH FIELD NOTES

6-1-84 LAPHAM, L.C.R.C. 741
SAME AS (132) 4-175

11-13-84 LAPHAM, UNRECORDED SURVEY
SAME AS (132) 4-175

B. Description of corner evidence found and/or method applied in restoring or reestablishing corner:

FOUND TWO 1/2"x18" RE-RODS AND ONE 1/2"x6" RE-ROD ON LARGE ROCK. MOVED ROCK SLIGHTLY TO SET STANDARD CORNER. FOUND 1983 WITNESSES. FOUND AND REJECTED 1/2" IRON IN 1 1/2" PIPE 8.4 FEET N.W. OF CORNER ON SINGLE PROPORTIONAL MEASURE BETWEEN N.W. & S.W. SECTION CORNERS.

ACCEPTED BY THE ISABELLA COUNTY
REMONUMENTATION PEER GROUP
ON 2/7/95
William B. Ruddell, PS
County Representative

This Corner established in Isabella County Remonumentation Program.

See dossier for detailed report.

C. Description of monument for corner and accessories established to perpetuate locating the position of the corner:

E-4: 1/4 CORNER, COMMMON TO SECTIONS 8 & 9
SET 1/2"x24" STANDARD MONUMENT WITH CAP MARKED E-4, P.S. 9433.
ACCEPTED AS BEST AVAILABLE EVIDENCE OF ACCEPTED POSITION OF THE CORNER.

WITNESSES:
N70°E 101.65' - NAIL & TAG IN 15" SCOTCH PINE
S45°W 46.31' - NAIL & TAG IN POWER POLE
S45°E 47.56' - CENTER OF PIPE RISER
N45°E 104.30' - NAIL & TAG IN 6" ELM

STATE OF MICHIGAN
PAUL B. LAPHAM
PROFESSIONAL SURVEYOR
No. 9433
LICENSED PROFESSIONAL SURVEYOR

Signed by Paul B. Laphom Date 12-01-95

Surveyor's Michigan License No. 9433

FORM APPROVED BY MICHIGAN STATE BOARD OF PROFESSIONAL SURVEYORS, JAN. 28, 1971
REVISED MAY 14, 1975
REVISED JAN., 1983