

**SURVEY & REMONUMENTATION**

APR 29 1996

**COMMISSION**

**REMONUMENTATION CORNER**

**LAND CORNER RECORDATION CERTIFICATE**

Filing Requirement of Act 74, Mich. P.A. 1970

For corners in ISABELLA  
(County)

Located in:

Corner Code #

- |                                      |   |            |   |           |            |
|--------------------------------------|---|------------|---|-----------|------------|
| 1. Public Land Survey                | T | <u>16N</u> | R | <u>5W</u> | <u>F-5</u> |
|                                      | T |            | R |           |            |
|                                      | T |            | R |           |            |
|                                      | T |            | R |           |            |
| 2. Property Controlling in Section   | S |            | T |           |            |
|                                      | S |            | T |           |            |
| 3. Miscellaneous Property in Section | S |            | T |           |            |
|                                      | S |            | T |           |            |
4. Lot No. \_\_\_\_\_, Recorded Plat \_\_\_\_\_
5. Private Claims \_\_\_\_\_

STATE OF MICHIGAN  
COUNTY OF ISABELLA  
RECEIVED FOR RECORD

DEC 11 10 38 AM '95

000085

SHARON A. BROWN  
REGISTER OF DEEDS

Register of Deeds Stamp & File Number

A	B	C	D	E	F	G	H	I	J	K	L	M
2	6	5	4	3	2	1						
3												
4	7	8	9	10	11	12						
5												
6	18	17	16	15	14	13						
7												
8	19	20	21	22	23	24						
9												
10	30	29	28	27	26	25						
11												
12	31	32	33	34	35	36						
13												

I, PAUL B. LAPHAM, in a field survey on NOVEMBER, 19 95, do hereby certify that under requirements of P.A. 74, Michigan P.A. of 1970, the corner points mentioned in lines 1 and 2 above were in conformance with regulations and rules therefore as required in the current manual of survey instructions of the United States Department of the Interior, Bureau of Land Management or by a decree of a Court of Law and/or that the corner points mentioned in lines 3, 4 and 5 above were in conformance with the rules of the Michigan Board of Professional Surveyors or by a Decree of a Court of Law; established, re-established, monumented, re-monumented, recovered, found as expressed below:

**NOTE: Not more than 4 corners, all in the same town and range, may be recorded on this certificate.**

**A. Description of original monument and accessories and/or subsequent restoration:**

18L37 NICHOLSON, G.L.O.

1850 BURT, G.L.O. RESURVEY

SET POST

WIT.-(1)CEDAR 11" - N17°E 27

(2)CEDAR 6" - S57°W 11

1909 TRUSSELL, C.S.R. 4-88

5x5x48 CEDAR STAKE IN WEST EDGE OF OLD STATE ROAD

WIT.-(3)CEDAR 4" S31°W 39 1/2 L

(4)B. ASH 10" N44°E 35 1/2 L

9-20-78 LAPHAM, L.C.R.C. 493  
FOUND 2x2 HUB IN WEST DITCH OF OLD STATE ROAD.

WIT.-(5)S80°E 14.05' 5" MAPLE

(6)S50°E 23.50' 8" ASH


(7)N55°E 31.20' 8" ASH

(8)S15°W 14.40' 8" ASH

(INCLUDED COPY OF FIELD NOTES FROM PBL & A FILES)

**B. Description of corner evidence found and/or method applied in restoring or reestablishing corner:**

FOUND REMAINS OF OLD CEDAR POST IN WEST DITCH OF ABANDONED OLD STATE ROAD. FOUND 1978 WITNESSES BELIEVE CEDAR POST TO BE 1909 STAKE

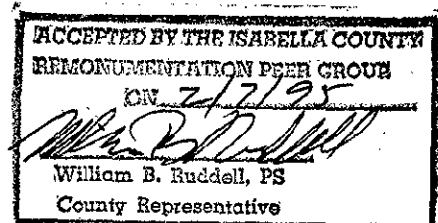

This Corner established in Isabella County Remonumentation Program.

See dossier for detailed report.

**C. Description of monument for corner and accessories established to perpetuate locating the position of the corner:**

F-5: 1/4 CORNER COMMON TO SECTIONS 9 & 16

REPLACED 2x2 HUB WITH 1/2"x24" STANDARD MONUMENT WITH CAP MARKED F-5, P.S. NO. 9433.

ACCEPTED AS BEST AVAILABLE EVIDENCE OF THE PERPUATION OF THE C.S.R. CORNER.

WITNESSES:

S80°E 14.05' - NAIL & TAG IN 8" MAPLE (OBT)

S50°E 23.50' - NAIL & TAG IN 12" ASH (OBT)

N55°E 31.20' - NAIL & TAG IN 11" ASH (OBT)

S15°W 14.40' - NAIL & TAG IN 17" ASH (OBT)



Signed by Paul B. Lapham

Date 12-01-95

Surveyor's Michigan License No. 9433