

MAR 09 1998

LAND CORNER RECORDATION CERTIFICATE
Filing Requirement of Act 74, Mich. P.A. 1970

SECTION

For Corners in
Isabella
(County)

9800001909
Filed for Record in
ISABELLA COUNTY, MI
SHARON A BROWN
On 02-27-1998 At 03:38:07 pm.
RE LAND COR 9.00
Book OR Vol. 1 Pg. 231 - 231

1. Public Land Survey T. 16N. R. 5W. Corner Code#: H-1
T. _____ R. _____
T. _____ R. _____
2. Public Controlling S. _____ T. _____ R. _____
in Section S. _____ T. _____ R. _____
3. Miscellaneous S. _____ T. _____ R. _____
Property in Section S. _____ T. _____ R. _____
4. Lot No. _____, Recorded Plat _____
5. Private Claims _____

Register of Deeds Stamp & File Number


I, Mark Robison, in a field survey on October 2, 1997, do hereby certify that under requirements of P.A. 74, Michigan P.A. of 1970, the corner points mentioned in lines 1 and 2 above were in conformance with regulations and rules therefore as required in the current manual of survey instructions of the United States Department of the Interior, Bureau of Land Management or by a decree of a Court of Law and/or that the corner points mentioned in lines 3, 4 and 5 above were in conformance with the rules of the Michigan Board of Land Surveyors or by a Decree of a Court of Law, established, re-established, monumented, re-monumented, recovered, found as expressed below.

NOTE: Not more than 2 corners, all in the same town and range, may be recorded on this certificate.

	A	B	C	D	E	F	G	H	I	J	K	L	M
1													
2	6	5	4	3	2	1							
3													
4	7	8	9	10	11	12							
5													
6	18	17	16	15	14	13							
7													
8	19	20	21	22	23	24							
9													
10	30	29	28	27	26	25							
11													
12	31	32	33	34	35	36							
13													

A. Description of original monument and accessories and/or subsequent restoration:

- Original G.L.O. Survey:
Township Lines: 2nd Quarter by John Hodgson, 1837
Subdivision & Re-survey: 4th Quarter by Henry Nicholson, 1837
- County Survey of Records:
Liber 4, Page 80, June 28-31, 1909, W. H. Trussell
- L.C.R.C.
Liber 1, Page 130 Paul B. Lapham
Liber 1, Page 307 John Radcliffe,
Liber 4, Page 1353 Mark Robison
- Surveys of Record:
Liber 1, Page 205 Paul B. Lapham December, 1972
Liber 1, Page 586 Fluharty Eng. July 30, 1974
- Unrecorded Surveys:
Clare files, Section map, Found 2" bolt with hub
P.B.L.&A., Certificate of Survey
P.B.L.&A., Certificate of Survey, Found 2" square bolt
P.B.L.&A., Certificate of Survey, Found 2" X 3" box channel in 6" steel pipe

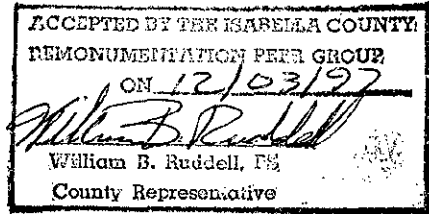

Found 2" square bolt head
Found 2" X 3" box channel in 6" steel pipe
Found 2" square bolt head

B. Description of corner evidence found and/or method applied in restoring or re-establishing corner:

This corner established in Isabella County Remonumentation Program. See dossier for detailed report.
Found 3/4" X 42" rod, with 2" X 2" X 12" square tubing on top of it
Inside 6" X 12" steel pipe. Augured down about 4' and Found Nothing else.
Found 3/4" pipe 50.7' West

Accepted as best available evidence of the position of the original corner and replaced with Standard Monument.

C. Description of monument for corner and accessories established to perpetuate locating the position of the corner:

Set Standard Isabella County Monument in a Monument Box marked PS 27458.

N34°W	45.35'	Nail & Tag in p.p.
N56°W	60.20'	Nail & Tag in p.p.
N50°E	54.90'	Nail & Tag in fence post
S46°E	64.00'	Nail & Tag in 14" R. Pine
West	50.70'	H-13, T.17N.-R.5W.



Signed by Mark R. Robison

Date 2-26-98

Surveyor's Michigan License No. 27458