

SURVEY & REMONUMENTATION

APR 29 1996

COMMISSION

**REMONUMENTATION CORNER
LAND CORNER RECORDATION CERTIFICATE
Filing Requirement of Act 74, Mich. P.A. 1970**

For corners in ISABELLA (County) Located In: _____ Corner Code # _____

1. Public Land Survey	T	<u>16N</u>	R	<u>5W</u>	<u>H-5</u>
	T	_____	R	_____	_____
	T	_____	R	_____	_____
	T	_____	R	_____	_____
2. Property Controlling in Section	S	_____	T	_____	R
	S	_____	T	_____	R
3. Miscellaneous Property in Section	S	_____	T	_____	R
	S	_____	T	_____	R

4. Lot No. _____, Recorded Plat _____

5. Private Claims _____

STATE OF MICHIGAN
COUNTY OF ISABELLA
RECEIVED FOR RECORD

DEC 11 10 38 AM '95
000080
SHARON A. BROWN
REGISTER OF DEEDS

Register of Deeds Stamp & File Number

I, PAUL B. LAPHAM, in a field survey on OCTOBER, 19 95, do hereby certify that under requirements of P.A. 74, Michigan P.A. of 1970, the corner points mentioned in lines 1 and 2 above were in conformance with regulations and rules therefore as required in the current manual of survey instructions of the United States Department of the Interior, Bureau of Land Management or by a decree of a Court of Law and/or that the corner points mentioned in lines 3, 4 and 5 above were in conformance with the rules of the Michigan Board of Professional Surveyors or by a Decree of a Court of Law; established, re-established, monumented, re-monumented, recovered, found as expressed below:

A	B	C	D	E	F	G	H	I	J	K	L	M
2	6	5	4	3	2	1						
3												
4	7	8	9	10	11	12						
5												
6	18	17	16	15	14	13						
7												
8	19	20	21	22	23	24						
9												
10	30	29	28	27	26	25						
11												
12	31	32	33	34	35	36						
13												

NOTE: Not more than 4 corners, all in the same town and range, may be recorded on this certificate.

A. Description of original monument and accessories and/or subsequent restoration:

1837 NICHOLSON, G.L.O.

P.B. LAPHAM & ASSOC. RECORDS INDICATE THIS POSITION IS IN ERROR AND SURVEY HAS BEEN CORRECTED TO POSITION SHOWN ON 7-10-85 SURVEY.

1850 BURT, G.L.O. RESURVEY
SET POST
WIT.-(1)HEMLOCK 8" S34°E 11'
(2)CEDAR 11" N9°W 27'


7-10-85 LAPHAM, UNRECORDED SURVEY
FOUND OLD 4" CEDAR POST
SET 1/2" CAPPED RE-ROD
WIT.-(3)S45°W 18.90' 18" ASH
(7)S10°W 18.52' 4" ELM
(8)EAST 13.62' 8" ELM

4-20-78 (132) 3-194
FOUND PILE OF STONE & FENCE COR.
WIT.-(3)N30°W 18.90' 12" ASH
(4)N70°E 14.0' 8" CEDAR
(5)S20°E 31.2' 12" MAPLE
(6)S50°W 28.9' 4" MAPLE

8-26-86 LAPHAM, L.C.R.C.
FOUND OLD 4" CEDAR POST, SET 1/2" CAPPED RE-ROD
WIT.-SAME AS 7-10-85

B. Description of corner evidence found and/or method applied in restoring or reestablishing corner:

FOUND 1/2"x18" CAPPED RE-ROD BESIDE 4" CEDAR POST. MEASURED NORTH 200 FEET TO C.I. PER 7-10-85 SURVEY. ALL WITNESSES DESTROYED DUE TO ROAD AND FENCE CONSTRUCTION.

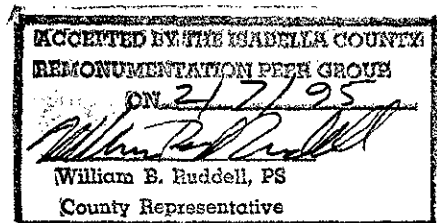


This Corner established in Isabella County Remonumentation Program.

See dossier for detailed report.

C. Description of monument for corner and accessories established to perpetuate locating the position of the corner:

H-5: 1/4 CORNER COMMON TO SECTIONS 10 & 15
SET 1/2"x24" STANDARD MONUMENT WITH CAP MARKED H-5 P.S. NO. 9433
ACCEPTED AS BEST AVAILABLE EVIDENCE OF ACCEPTED POSITION OF THE CORNER.

WITNESSES:
NORTH 17.4' - NAIL & TAG IN 6" ELM
N10°W 20.05' - NAIL & TAG IN 5" ELM
N85°W 22.15' - NAIL & TAG IN 10" ASH
SOUTH 38.34' - NAIL & TAG IN 24" ASH

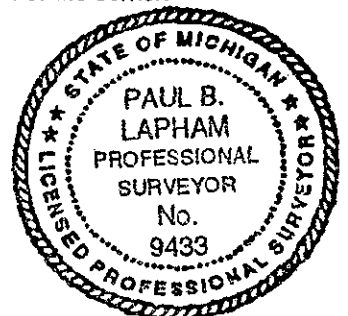

Signed by Paul B. Lapham

Date 12-01-95

Surveyor's Michigan License No. 9433