SURVEY & REMONUMENTATION
APR 2 9 1996
COMMISSION

REMONUMENTATION CORNER

LAND CORNER RECORDATION CERTIFICATE

Filing Requirement of Act 74, Mich. P.A. 1970

STATE OF MICHIGAN
COUNTY OF ISABELLA
RECEIVED FOR RECORD
DEC 11 10 38 AM '95
000081
SHARON A. BROWN
REGISTER OF DEEDS

Register of Deeds Stamp & File Number

For corners in ISABELLA (County) Located In: Corner Code #

1. Public Land Survey T 16N R 5W 1-7
   T ___ R ___
   T ___ R ___
   T ___ R ___
2. Property Controlling S ___ T ___ R ___
   in Section S ___ T ___ R ___
3. Miscellaneous S ___ T ___ R ___
   Property in Section S ___ T ___ R ___

4. Lot No. _____, Recorded Plat _____
5. Private Claims _____

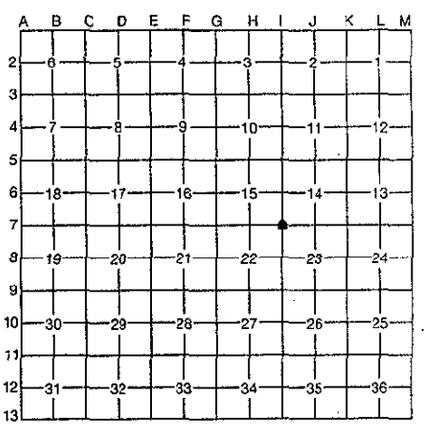

I, PAUL B. LAPHAM, in a field survey on OCTOBER, 19 95, do hereby certify that under requirements of P.A. 74, Michigan P.A. of 1970, the corner points mentioned in lines 1 and 2 above were in conformance with regulations and rules therefore as required in the current manual of survey instructions of the United States Department of the Interior, Bureau of Land Management or by a decree of a Court of Law and/or that the corner points mentioned in lines 3, 4 and 5 above were in conformance with the rules of the Michigan Board of Professional Surveyors or by a Decree of a Court of Law; established, re-established, monumented, re-monumented, recovered, found as expressed below:

NOTE: Not more than 4 corners, all in the same town and range, may be recorded on this certificate.

A. Description of original monument and accessories and/or subsequent restoration:

1837 NICHOLSON, G.L.O.

1850 BURT, G.L.O. RESURVEY
POST IN HEMLOCK 18" DIA.

1902 TRUSSELL, C.S.R. 3-179, C.S.R. 1-88
STONE "X"
WITNESSES:(1)CORNER OF STONE WALL OF CHURCH
S45 1/2°W 137 1/4
(2)S.W. CORNER HALL STONE WALL
N58° 1/2 E, 117 1/4

1905 UNKNOWN, C.S.R. 4-46
3x3 OAK STAKE
WITNESSES:(1) & (2) ABOVE

10-19-73 LAPHAM, (132) 1-440
FOUND 3/4" IRON
WITNESSES:(3)N30°E 39.10' R/W MARKER
(4)S60°E 64.35' R/W MARKER
(5)S45°W 48.50' POWER POLE

11-05-73 LAPHAM, L.C.R.C. 456
FOUND 3/4" IRON
WITNESSES:(3), (4) & (5) ABOVE

B. Description of corner evidence found and/or method applied in restoring or reestablishing corner:

FOUND 3/4"x14" IRON IN ASPHALT PAVEMENT. FOUND 1902 WITNESS (TWP. HALL). FOUND TWO WITNESSES FROM 1973 SURVEY.

ACCEPTED BY THE ISABELLA COUNTY
REMONUMENTATION PEER GROUP
ON 2/7/95
William B. Ruddell, PS
County Representative

This Corner established in Isabella County Remonumentation Program.

See dossier for detailed report.

C. Description of monument for corner and accessories established to perpetuate locating the position of the corner:

1-7: CORNER COMMON TO SECTIONS 14, 15, 22 & 23
SET 1/2"x24" STANDARD MONUMENT WITH CAP MARKED 1-7 P.S. 9433 IN MONUMENT BOX IN 8" DEEP ASPHALT PAVEMENT.
ACCEPTED AS BEST AVAILABLE EVIDENCE OF THE PERPETUATION OF C.S.R. CORNER.

WITNESSES:
N58°E 77.4' - S.W. CORNER TWP. HALL (OBT)
S60°E 64.35' - R/W MARKER (OBT)
S45°W 48.50' - NAIL & TAG IN POWER POLE (OBT)
N68°W 65.00' - NAIL & TAG IN 11" CEDAR

STATE OF MICHIGAN
PAUL B. LAPHAM
PROFESSIONAL SURVEYOR
No. 9433
LICENSED PROFESSIONAL SURVEYOR

Signed by Paul B. Lapham Date 12-01-95

Surveyor's Michigan License No. 9433

FORM APPROVED BY MICHIGAN STATE BOARD OF PROFESSIONAL SURVEYORS, JAN. 28, 1971
REVISED MAY 14, 1975
REVISED JAN., 1983