

MAR 09 1998

01901

LAND CORNER RECORDATION CERTIFICATE SECTION  
Filing Requirement of Act 74, Mich. P.A. 1970

For Corners in  
Isabella

(County)

Located In: Corner Code#

Filed for Record in  
ISABELLA COUNTY, MI  
SHARON A BROWN  
On 02-27-1998 At 03:38:16 pm.  
RE LAND COR 9.00  
Book OR Vol. 1 Pg. 233 - 233

- 1. Public Land Survey T. 16N. R. 5W. J-1
- T. \_\_\_\_\_ R. \_\_\_\_\_
- T. \_\_\_\_\_ R. \_\_\_\_\_
- 2. Public Controlling S. \_\_\_\_\_ T. \_\_\_\_\_ R. \_\_\_\_\_  
in Section S. \_\_\_\_\_ T. \_\_\_\_\_ R. \_\_\_\_\_
- 3. Miscellaneous S. \_\_\_\_\_ T. \_\_\_\_\_ R. \_\_\_\_\_  
Property in Section S. \_\_\_\_\_ T. \_\_\_\_\_ R. \_\_\_\_\_
- 4. Lot No. \_\_\_\_\_, Recorded Plat \_\_\_\_\_
- 5. Private Claims \_\_\_\_\_

Register of Deeds Stamp & File Number


I, Mark Robison, in a field survey on October 2, 1997, do hereby certify that under requirements of P.A. 74, Michigan P.A. of 1970, the corner points mentioned in lines 1 and 2 above were in conformance with regulations and rules therefore as required in the current manual of survey instructions of the United States Department of the Interior, Bureau of Land Management or by a decree of a Court of Law and/or that the corner points mentioned in lines 3, 4 and 5 above were in conformance with the rules of the Michigan Board of Land Surveyors or by a Decree of a Court of Law, established, re-established, monumented, re-monumented, recovered, found as expressed below.

NOTE: Not more than 2 corners, all in the same town and range, may be recorded on this certificate.

	A	B	C	D	E	F	G	H	I	J	K	L	M
1													
2	6	5	4	3	2	1							
3													
4	7	8	9	10	11	12							
5													
6	18	17	16	15	14	13							
7													
8	19	20	21	22	23	24							
9													
10	30	29	28	27	26	25							
11													
12	31	32	33	34	35	36							
13													

A. Description of original monument and accessories and/or subsequent restoration:

- 1. Original G.L.O. Survey:  
Township Lines: 2<sup>nd</sup> Quarter by John Hodgson, 1837  
Subdivision & Re-survey: 4<sup>th</sup> Quarter by Henry Nicholson, 1837
- 2. County Survey of Records:  
Liber 3, Page 166, November 1901, E.R. Coburn  
Sm. Liber 1, Page 62, November 16, 1901, E.R. Coburn
- 3. L.C.R.C.  
Liber 2, Page 527 Herbert Fluharty Set 5/8" iron with cap
- 4. Surveys of Record:  
None
- 5. Unrecorded Surveys:  
Mears Eng, Plat of Survey, Set 5/8" iron with cap in centerline of old 2 track

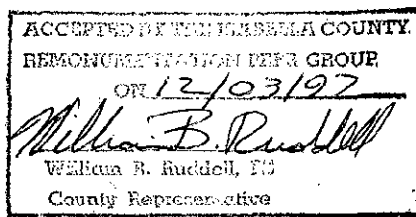

B. Description of corner evidence found and/or method applied in restoring or re-establishing corner:

This corner established in Isabella County Remonumentation Program. See dossier for detailed report.


Found two 5/8" X 18" capped irons 3.2 feet apart. Northwesternly iron was capped (Mears Eng.) and fit 1978 witnesses Found J-13, T.17N.-R.5W., approximately 75 feet West on a fence line to North.

Accepted as best available evidence of the position of the original corner and replaced with Standard Monument.

C. Description of monument for corner and accessories established to perpetuate locating the position of the corner:

Set Standard Isabella County Monument in a Monument Box marked PS 27458.

N44°W	29.65'	Nail & Tag in 16" R. Oak
South	38.65'	Nail & Tag in 18" R. Oak
S49°E	37.20'	Nail & Tag in 12" R. Oak
N20°E	25.5'	Nail & Tag in 13" Poplar
NW	75.0+/-	J-13, T.17N.-R.5W.

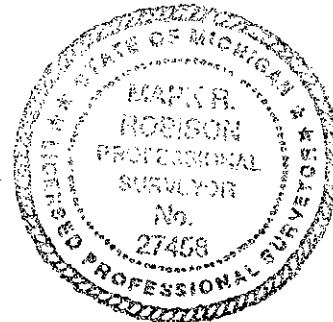

Signed by Mark R. Robison  
Surveyor's Michigan License No. 27458

Date 2-26-98