

LAND CORNER RECORDATION CERTIFICATE

MAR 09 1999

Filing Requirement of Act 74, Mich. P.A. 1970

Isabella County Remonumentation

SECTION

000240

07319

For Corners in

Isabella

(County)

Located In:

Corner Code#:

- 1. Public Land Survey T. 16N. R. 6W. M-5  
T. \_\_\_\_\_ R. \_\_\_\_\_  
T. \_\_\_\_\_ R. \_\_\_\_\_
- 2. Public Controlling S. \_\_\_\_\_ T. \_\_\_\_\_ R. \_\_\_\_\_  
in Section S. \_\_\_\_\_ T. \_\_\_\_\_ R. \_\_\_\_\_
- 3. Miscellaneous S. \_\_\_\_\_ T. \_\_\_\_\_ R. \_\_\_\_\_  
Property in Section S. \_\_\_\_\_ T. \_\_\_\_\_ R. \_\_\_\_\_
- 4. Lot No. \_\_\_\_\_, Recorded Plat \_\_\_\_\_
- 5. Private Claims \_\_\_\_\_

9800007319

Filed for Record in ISABELLA COUNTY, MI

SHARON A BROWN

On 07-20-1998 At 03:00:47 pm.

RE LAND COR 9.00

OR Liber 1 Page 240 - 240

Register of Deeds Stamp & File Number


I, Mark Robison, in a field survey on July, 1997, do hereby certify that under requirements of P.A. 74, Michigan P.A. of 1970, the corner points mentioned in lines 1 and 2 above were in conformance with regulations and rules therefore as required in the current manual of survey instructions of the United States Department of the Interior, Bureau of Land Management or by a decree of a Court of Law and/or that the corner points mentioned in lines 3, 4 and 5 above were in conformance with the rules of the Michigan Board of Land Surveyors or by a Decree of a Court of Law, established, re-established, monumented, re-monumented, recovered, found as expressed below.

NOTE: Not more than 2 corners, all in the same town and range, may be recorded on this certificate.

1	A	B	C	D	E	F	G	H	I	J	K	L	M
2	6	5	4	3	2	1							
3													
4	7	8	9	10	11	12							
5													
6	18	17	16	15	14	13							
7													
8	19	20	21	22	23	24							
9													
10	30	29	28	27	26	25							
11													
12	31	32	33	34	35	36							
13													

A. Description of original monument and accessories and/or subsequent restoration:

- 1. G.L.O Original Survey  
Township Lines: 2nd Quarter 1837 John Hodgson  
Subdivision: 1st Quarter 1847 Orson Lyon  
Page 506 Original Field Notes  
This is a common corner with A-5, T.16N.,R.5W.
- 2. County Survey Records:  
Liber 3, Page 90, October 11, 1897, Trussell
- 3. L.C.R.C.  
None
- 4. Surveys of Record  
Liber 1, Page 261, January 14, 1971, Nowak, Land Division
- 5. Unrecorded Survey  
None

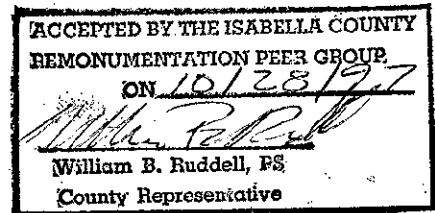

B. Description of corner evidence found and/or method applied in restoring or re-establishing corner:

This corner established in Isabella County Remonumentation Program. See dossier for detailed report. Found 1/2" iron at SW. corner of Lot 66 per Nowak survey. Purports to be (M-5) corner common to Section 12 and 13 on town line.

Found pointed stone marked X and old buggy axel (lying down) at corner per C.S.R. notes. Found 30" pine stump (notched) N.54°E., 60.1' (C.S.R. N.54.5°E., 60.55') and remains of pine stump N.38°W., 69.9' (C.S.R. N.35.5°W., 69.3'). Found fence corner S.52°W., 52.7' with fence South, North, and West (appears to be West Right of Way fence). Section corner per Nowak survey is N.45°W., 56.4'. Nowak states he found an iron pipe.

C. Description of monument for corner and accessories established to perpetuate locating the position of the corner: Set Standard Isabella County Monument.

M-5

- S.70°W. 7.95' Nail & tag in 7" Maple
- S.28°E. 18.10' Nail & tag in 6" Maple
- East 29.75' Nail & tag in 12" Oak
- N.22°E. 16.10' Nail & tag in 4" Oak



Signed by Mark R. Robison

Date 5/13/98

Surveyor's Michigan License No. 27458