

LAND CORNER RECORDATION CERTIFICATE

Filing Requirement of Act 74, Mich. P.A. 1970

MAR 09 1998

00115

Isabella County Remonumentation

SECTION 660218

For Corners in Isabella

(County)

Located In:

Corner Code#:

1. Public Land Survey

T. 16N. R. 5W.

A-7

T. 16N. R. 6W.

M-7

T. R.

2. Public Controlling in Section

S. T. R.

3. Miscellaneous Property in Section

S. T. R.

4. Lot No., Recorded Plat

5. Private Claims

9800000145  
Filed for Record in  
ISABELLA COUNTY, MI  
SHARON A BROWN  
On 01-06-1998 At 11:21:25 am.  
RE LAND COR 9.00  
Book OR Vol. 1 Pg. 218 - 218

Register of Deeds Stamp & File Number

I, Mark Robison, in a field survey on July, 1997, do hereby certify that under requirements of P.A. 74, Michigan P.A. of 1970, the corner points mentioned in lines 1 and 2 above were in conformance with regulations and rules therefore as required in the current manual of survey instructions of the United States Department of the Interior, Bureau of Land Management or by a decree of a Court of Law and/or that the corner points mentioned in lines 3, 4 and 5 above were in conformance with the rules of the Michigan Board of Land Surveyors or by a Decree of a Court of Law, established, re-established, nonumented, re-monumented, recovered, found as expressed below.

NOTE: Not more than 2 corners, all in the same town and range, may be recorded on this certificate.

	A	B	C	D	E	F	G	H	I	J	K	L	M
2	6	5	4	3	2	1							
3													
4	7	8	9	10	11	12							
5													
6	18	17	16	15	14	13							
7													
8	19	20	21	22	23	24							
9													
10	30	29	28	27	26	25							
11													
12	31	32	33	34	35	36							
13													

A. Description of original monument and accessories and/or subsequent restoration:

1. G.L.O Original Survey

Township Lines: 2nd Quarter 1837 John Hodgson  
Subdivision and Resurvey: 4th Quarter 1837 H. Nicholson  
Page 506 Original Field Notes

County Survey Records:

Liber 3, Page 90, October 11, 1897, Trussell  
Liber 4, Page 23, September, 1904, Denslow  
Liber 4, Page 105, 1910, Trussell  
Sm. Liber 1, Page 200, September 2, 1904, Denslow

L.C.R.C.

Liber 1, Page 335, April 21, 1975, Fluharty, 3/8" bar and 1 1/2" x 1/4" flat iron

Surveys of Record

None

Unrecorded Survey

Mears Engineering files, field notes and field drawing

Description of corner evidence found and/or method applied in restoring or re-establishing corner:



This corner established in Isabella County Remonumentation Program. See dossier for detailed report.  
Found 1 1/4" x 1/4" x 26" bar and 5/8" x 15" bar over 1" diameter bar 3' deep. 1 1/4" x 1/4" x 26" bar is identical to iron found at B-7, i.e., bolt through end. Found stump with blaze N.51°W (1910 CSR notes N.58 1/4°W.) 74' from iron bar. Stump is blazed on SE. side. Measured 1322' North per 1897 CSR notes to line of occupation but no corner.

Accepted as best available evidence of the position of the original corner and replaced with Standard Monument Corner.

Description of monument for corner and accessories established to perpetuate locating the position of the corner:

Set Standard Isabella County Monument in Monument Box.

N.34°W. 47.73' Nail & tag in power pole  
N.39°E. 96.00' Nail & tag in 14" Pine  
S.38°W. 65.25' Nail & tag in 15" Apple  
N.16°E. 136.50' Nail & tag in 14" Oak

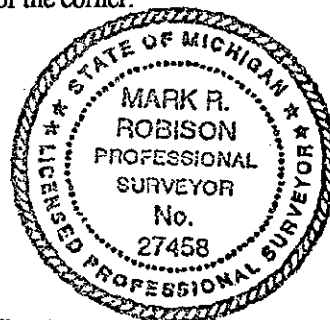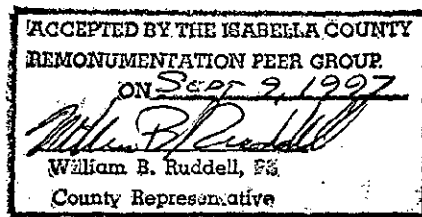

Recorded by Mark R. Robison  
Surveyor's Michigan License No. 27458

Date 12-30-97