

Sec. 36 T15 R12



M-12

COINERS FOUND BY WATER IN P.

Fine Clay post, N. E. Cor.

+ flush with ground.

See Bk. Page 37.


















object SURVEYERS.

E-12

1/4 Post Com. to Sec 32-33 T15 R2E

Line Passes 6.5' R. of Post

J.C. ROAD Comm.

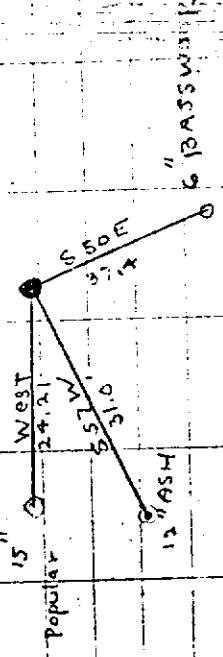

E-2

1/4 Post Sec 445 T. 2 S, 2 E

16' W. D.W.

