

**JACKSON COUNTY  
APPROVED LAND CORNER  
P.A. 345 of 1990**

Chairman Don K. Johnson  
Date April 9, 1997

West 1/4 Corner of Section 31, Henrietta Township  
LAND CORNER RECORDATION CERTIFICATE  
Filing Requirement of Act 74, Mich. P.A. 1970

#2031960  
Liber 1540 Page 141  
Page 1 of 1  
Jackson Co., MI  
Recorded  
04/10/97 09:24A  
Mindy Reilly  
Register of Deeds

For corners in JACKSON (County) Located In: Corner Code # A-12

1. Public Land Survey	T <u>  </u> R <u>  </u>	<u>  </u>
	T <u>  </u> R <u>  </u>	<u>  </u>
	T <u>  </u> R <u>  </u>	<u>  </u>
2. Property Controlling in Section	S <u>  </u> T <u>  </u> R <u>  </u>	<u>  </u>
	S <u>  </u> T <u>  </u> R <u>  </u>	<u>  </u>
3. Miscellaneous Property in Sec.	S <u>  </u> T <u>  </u> R <u>  </u>	<u>  </u>
	S <u>  </u> T <u>  </u> R <u>  </u>	<u>  </u>
4. Lot No. <u>  </u> , Recorded Plat <u>  </u>		
5. Private Claims <u>  </u>		

**SURVEY &  
REMONUMENTATION**  
APR 07 1998  
**SECTION**

Register of Deeds Stamp & File Number

	A	B	C	D	E	F	G	H	I	J	K	L	M
1													
2	6	5	4	3	2	1							
3													
4	7	8	9	10	11	12							
5													
6	18	17	16	15	14	13							
7													
8	19	20	21	22	23	24							
9													
10	30	29	28	27	26	25							
11													
12	31	32	33	34	35	36							
13													

I, David E. Erickson, in a field survey on February 14, 19 97, do hereby certify that under requirements of P.A. 74, Michigan P.A. of 1970, the corner points mentioned in lines 1 and 2 above were in conformance with regulations and rules therefore as required in the current manual of survey instructions of the United States Department of the Interior, Bureau of Land Management or by a decree of a Court of Law and/or that the corner points mentioned in lines 3, 4 and 5 above were in conformance with the rules of the Michigan Board of Land Surveyors or by a Decree of a Court of Law; established, re-established, monumented, re-monumented, recovered, found as expressed below.

NOTE: Not more than 4 corners, all in the same town and range, may be recorded on this certificate.

A. Description of original monument and accessories and/or subsequent restoration:

This corner not established in original government survey of 1825, nor subsequently by H.F. Bean around 1888. No evidence of this corner having ever been monumented in the field.

B. Description of corner evidence found and/or method applied in restoring or reestablishing corner:


Searched area on Meridian Line, midway between "A-13" as remonumented and "A-11" as calculated in lake. Midpoint falls in centerline of North-South ditch, West of a man-made pond. No evidence of any fence running East from this corner.  
Established corner on Meridian Line between corners "M-11" and "M-12" of T1S-R1W, as remonumented, midway between corners "A-11" and "A-13" T1S-R1E, as remonumented. Set a 5 foot aluminum pipe with cap to monument corner.

C. Description of monument for corner and accessories established to perpetuate locating the position of the corner:

Set a 60" aluminum pipe with Jackson County standard aluminum cap stamped "T1S-R1E, A-12, 1997, LS #29245".

S 67° E	Set nail & tag #29245, North side 9" Hickory	296.71'
S 40° E	Set nail & tag #29245, East side 17" Oak	255.78'
S 15° E	Set nail & tag #29245, West side 14" Oak	175.21'
S 45° W	Set nail & tag #29245, Southeast side 2" Oak	105.34'
North	County Surveyor sign post	1.0'
East	West bank of dike	12'
Northerly	Corner "M-11" T1S-R1W as remonumented	2088.59'
Northerly	Corner "A-11" T1S-R1E as calculated in lake	2669.38'
Southerly	Corner "A-13" T1S-R1E as remonumented	2669.38'
Southerly	Corner "M-12" T1S-R1W as remonumented	553.42'

NOTE: Bearings are magnetic

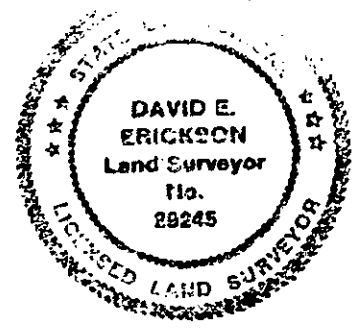

Signed by David E. Erickson Date 4-8-97

Surveyor's Michigan License No. 29245

Record 277