

Chairman Alan R. Schepelman
 Date Dec. 27, 1994

SOUTHWEST CORNER, SECTION 31, HENRIETTA TOWNSHIP

LIBER 1450 PAGE 565

LAND CORNER RECORDATION CERTIFICATE
 Filing Requirement of Act 74, Mich. P.A. 1970

For corners in

| | | |
|---------------------------------------|-------------------------|------------------------|
| <u>Jackson</u> (County) | Located In: | Corner Code # |
| 1. Public Land Survey | T <u>1S</u> R <u>1E</u> | <u>A-13</u> |
| | T _____ R _____ | <u>SURVEY &</u> |
| | T _____ R _____ | <u>REMONUMENTATION</u> |
| | T _____ R _____ | <u>MAY 0 8 1995</u> |
| 2. Property Controlling in Section | S _____ T _____ R _____ | <u>COMMISSION</u> |
| | S _____ T _____ R _____ | |
| 3. Miscellaneous Property in Sec. | S _____ T _____ R _____ | |
| | S _____ T _____ R _____ | |
| 4. Lot No. _____, Recorded Plat _____ | | |
| 5. Private Claims _____ | | |

STATE OF MICHIGAN
 JACKSON COUNTY
 RECORDED

27 DEC 94 12:11 P.M.

GERALD J. McDEVITT
 REGISTER OF DEEDS

Register of Deeds Stamp & File Number

I, Alan L. Schepelman in a field survey on December 21, 1994, do hereby certify that under requirements of P.A. 74, Michigan P.A. of 1970, the corner points mentioned in lines 1 and 2 above were in conformance with regulations and rules therefore as required in the current manual of survey instructions of the United States Department of the Interior, Bureau of Land Management or by a decree of a Court of Law and/or that the corner points mentioned in lines 3, 4 and 5 above were in conformance with the rules of the Michigan Board of Land Surveyors or by a Decree of a Court of Law; established, re-established, monumented, re-monumented, recovered, found as expressed below:

NOTE: Not more than 4 corners, all in the same town and range, may be recorded on this certificate.

| A | B | C | D | E | F | G | H | I | J | K | L | M |
|----|----|----|----|----|----|----|---|---|---|---|---|---|
| 2 | 6 | 5 | 4 | 3 | 2 | 1 | | | | | | |
| 3 | | | | | | | | | | | | |
| 4 | 7 | 8 | 9 | 10 | 11 | 12 | | | | | | |
| 5 | | | | | | | | | | | | |
| 6 | 18 | 17 | 16 | 15 | 14 | 13 | | | | | | |
| 7 | | | | | | | | | | | | |
| 8 | 19 | 20 | 21 | 22 | 23 | 24 | | | | | | |
| 9 | | | | | | | | | | | | |
| 10 | 30 | 29 | 28 | 27 | 26 | 25 | | | | | | |
| 11 | | | | | | | | | | | | |
| 12 | 31 | 32 | 33 | 34 | 35 | 36 | | | | | | |
| 13 | | | | | | | | | | | | |

A. Description of original monument and accessories and/or subsequent restoration:

JOSEPH WAMPLER NOV., 1825 SET POST IN ORIGINAL GOVERNMENT SURVEY.
 ELM 18, S85½°E, 19 LINKS (12.54')
 B. OAK 13, N9½°E, 50 LINKS (33.00')

H.F. BEAN 1888 POST AND WITNESSES STANDING.
 W. OAK 24, N69°E, 137½ LINKS (90.75')
 HICKORY 18, S41°E, 190 LINKS (125.40')

\$ 2.00 REMONUMENTATION
 \$ 7.00 CORNER REMONUMENTATION

RONNIE LESTER NOV. 2, 1988 FOUND BROKEN FIRECLAY IN NORTH-SOUTH FENCE.
 SET 1/2" BAR AND CAP ADJACENT TO BOTTOM OF FIRECLAY
 LCRC L.4 P.85 AND SET FIVE WITNESSES (ALL NAILS AND TAGS WITH #18998).


B. Description of corner evidence found and/or method applied in restoring or reestablishing corner:

FOUND BROKEN FIRECLAY AS RECORDED BY RONNIE LESTER, PS #18998, IN 1988.
 ALL WITNESS TREES ARE STANDING AND ONLY ONE NAIL WAS OVERGROWN. ACCEPTED THE FIRECLAY AS A PERPETUATION OF THE POSITION OF THE ORIGINAL CORNER AS REMONUMENTED IN 1885. SET A STANDARD JACKSON COUNTY REMONUMENTATION MONUMENT IN ITS PLACE AND BURIED BOTH PIECES OF THE FIRECLAY ON THE NORTH SIDE OF MONUMENT.

C. Description of monument for corner and accessories established to perpetuate locating the position of the corner:

4" x 36" CONCRETE MONUMENT WITH A JACKSON COUNTY REMONUMENTATION CAP
 STAMPED LS35998, 1" ABOVE GROUND.

| | | |
|-------|---|---------|
| S40°W | SET 20d NAIL & RAISED SHINER OVER LESTER NAIL IN NW SIDE OF TRI ASH | 22.55' |
| N15°E | SET 20d NAIL & RAISED SHINER OVER LESTER NAIL IN W. SIDE OF 15" OAK | 28.12' |
| N51°E | SET 20d NAIL & RAISED SHINER IN W. SIDE OF 14" OAK | 39.51' |
| S85°E | FOUND NAIL & TAG #18998 IN N. SIDE OF 24" SHAGBARK HICKORY | 103.11' |
| S70°E | FOUND NAIL & TAG #18998 IN S. SIDE OF 24" SHAGBARK HICKORY | 71.66' |
| S20°E | SET 20d NAIL & RAISED SHINER IN E. SIDE OF 14" CHERRY | 61.85' |

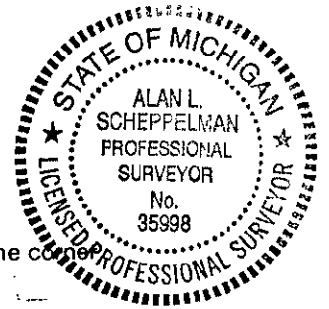

Signed by Alan L. Schepelman Date 12/23/94

Surveyor's Michigan License No. 35998