

**JACKSON COUNTY
APPROVED LAND CORNER
P.A. 345 of 1990**

Chairman Neal J. Johnson
Date MAR. 11, 1996

Center of Section 29, Henrietta Township
LAND CORNER RECORDATION CERTIFICATE
Filing Requirement of Act 74, Mich. P.A. 1970

#2023479
Liber 1534 Page 10
Page 1 of 1
Jackson Co., MI
Recorded
12/26/96 11:31A
Jerry McDevitt
Register of Deeds

For corners in <u>JACKSON</u> (County)	Located In:	Corner Code #
1. Public Land Survey	T <u>1S</u> R <u>1E</u>	<u>D-10</u>
	T _____ R _____	_____
	T _____ R _____	_____
	T _____ R _____	_____
2. Property Controlling in Section	S _____ T _____ R _____	_____
	S _____ T _____ R _____	_____
3. Miscellaneous Property in Sec.	S _____ T _____ R _____	_____
	S _____ T _____ R _____	_____
4. Lot No. _____, Recorded Plat _____		
5. Private Claims _____		

Register of Deeds Stamp & File Number

	A	B	C	D	E	F	G	H	I	J	K	L	M
1													
2	6		5		4		3		2		1		
3													
4	7		8		9		10		11		12		
5													
6	18		17		16		15		14		13		
7													
8	19		20		21		22		23		24		
9													
10	30		29		28		27		26		25		
11													
12	31		32		33		34		35		36		
13													

I, David E. Erickson in a field survey on December 22, 19 95, do hereby certify that under requirements of P.A. 74, Michigan P.A. of 1970, the corner points mentioned in lines 1 and 2 above were in conformance with regulations and rules therefore as required in the current manual of survey instructions of the United States Department of the Interior, Bureau of Land Management or by a decree of a Court of Law and/or that the corner points mentioned in lines 3, 4 and 5 above were in conformance with the rules of the Michigan Board of Land Surveyors or by a Decree of a Court of Law, established, re-established, monumented, re-monumented, recovered, found as expressed below:

NOTE: Not more than 4 corners, all in the same town and range, may be recorded on this certificate.

A. Description of original monument and accessories and/or subsequent restoration:

Corner not established in original survey nor subsequently by Bean. Corner is shown as being the Southeast corner of "Apple Blossom Park Subdivision" as recorded in Liber 13 of Plats, Page 4. Said plat was dated 12-24-1929 and was completed by "National Survey Service, Civil Engineers & Surveyors, 317 W. Fort St., Detroit, MI".

B. Description of corner evidence found and/or method applied in restoring or reestablishing corner:


Established the true center of section at intersection of 1/4 lines. Placed a 60" long aluminum pipe with cap at this position. Also established Southeast corner of "Apple Blossom Park" based upon found monumentation along East and South lines of said subdivision. This corner falls near an apparent old fence corner, fences running North & West and 16.0' South and 2.2' West of the Center of Section, as I have monumented.

C. Description of monument for corner and accessories established to perpetuate locating the position of the corner:

Set 60" long aluminum pipe with Jackson County Remonumentation Cap stamped "D-10, 1995, LS #29245,".

N 11° E	Set Spike & Tag #29245, West side 10" Ash	30.50'
N 60° W	Set Spike & Tag #29245, North side 12" Maple	135.35'
S 40° W	Set Spike & Tag #29245, West side 26" Ash	118.78'
S 23° E	Set Spike & Tag #29245, East side 10" Ash	52.04'
S 37° E	Set Spike & Tag #29245, Southwest side 12" Ash	29.32'
S 12° W	Southeast corner "Appleblossom Park Sub" (Set 1/2" Rebar W/ Cap #29245")	16.04'
S 45° E	County Surveyor sign post	0.9'

NOTE: Bearings are magnetic

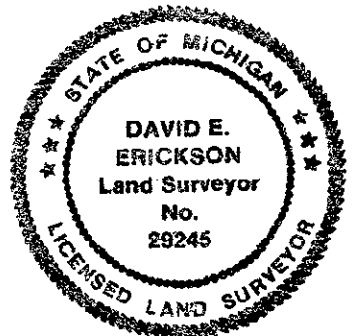

Signed by David E. Erickson Date 12-23-96

Surveyor's Michigan License No. 29245