

**JACKSON COUNTY  
APPROVED LAND CORNER  
P.A. 345 of 1990**

CENTER OF SECTION 34, HENRIETTA TOWNSHIP

Chairman *Alan L. Scheppelman*

**LAND CORNER RECORDATION CERTIFICATE  
Filing Requirement of Act 74, Mich. P.A. 1970**

Date Nov. 13, 1996

corners in

Jackson (County)	Located In:	Corner Code #
Public Land Survey	T 1S R 1E	H-12
	T ___ R ___	_____
	T ___ R ___	_____
	T ___ R ___	_____
Property Controlling in Section	S ___ T ___ R ___	_____
Miscellaneous Property in Sec.	S ___ T ___ R ___	_____

#2022272  
Liber 1533 Page 169  
Page 1 of 1  
Jackson Co., MI  
Recorded  
12/11/96 11:31A  
Jerry McDevitt  
Register of Deeds

Register of Deeds Stamp & File Number

Lot No. \_\_\_\_\_, Recorded Plat \_\_\_\_\_  
Private Claims \_\_\_\_\_

	A	B	C	D	E	F	G	H	I	J	K	L	M
2	6	5	4	3	2	1							
3													
4	7	8	9	10	11	12							
5													
6	18	17	16	15	14	13							
7													
8	19	20	21	22	23	24							
9													
10	30	29	28	27	26	25							
11													
12	31	32	33	34	35	36							
13													

Alan L. Scheppelman, in a field survey on October 9, 1996,  
do hereby certify that under requirements of P.A. 74, Michigan P.A. of 1970, the corner points mentioned  
in lines 1 and 2 above were in conformance with regulations and rules therefore as required in the  
current manual of survey instructions of the United States Department of the Interior, Bureau of Land  
Management or by a decree of a Court of Law and/or that the corner points mentioned in lines 3, 4 and 5  
above were in conformance with the rules of the Michigan Board of Land Surveyors or by a Decree of a  
Court of Law; established, re-established, monumented, re-monumented, recovered, found as  
expressed below:

**NOTE: Not more than 4 corners, all in the same town and range, may be recorded  
on this certificate.**

A. Description of original monument and accessories and/or subsequent restoration:

POINT NOT SET IN ORIGINAL GOVERNMENT SURVEY AND NO RECORD THAT IT HAD  
EVER BEEN SET.


B. Description of corner evidence found and/or method applied in restoring or reestablishing corner:

SET JACKSON COUNTY MONUMENT AT THE INTERSECTION OF THE QUARTER LINES.  
POINT IS IN THE WOODS WITH NO EVIDENCE OF OCCUPATION. OTHER INTERIOR  
1/8 POSTS AGREE WITH EXISTING OCCUPATION.

C. Description of monument for corner and accessories established to perpetuate locating the position of the corner:

4" X 36" CONCRETE MONUMENT WITH JACKSON COUNTY REMONUMENTATION CAP  
STAMPED "H-12 T1S R1W LS NO. 35998".

N50°E	NAIL & TAG #35998 IN THE SOUTH SIDE OF 16" CHERRY	4.72'
S25°E	NAIL & TAG #35998 IN THE WEST OF 30" OAK	48.29'
S25°W	NAIL & TAG #35998 IN THE NW SIDE OF 20" CHERRY	31.96'
N50°W	NAIL & TAG #35998 IN THE NORTH SIDE OF 10" MAPLE	42.47'
N40°W	NAIL & TAG #35998 IN THE SOUTH SIDE OF 40" MAPLE	30.97'
SOUTH	SURVEY MARKER SIGN POST	1.1'

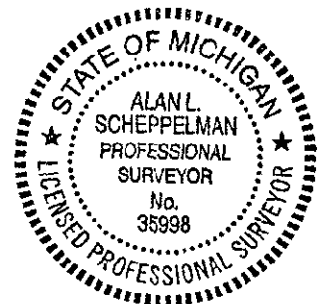

Signed by *Alan L. Scheppelman*

Date 11/07/96

Surveyor's Michigan License No. 35998