

JACKSON COUNTY
 APPROVED LAND CORNER
 P.A. 365 of 1990

Chairman Dean G. Johnson West 1/4 Corner of Section 14, Henrietta Township

Date April 9, 1997

LAND CORNER RECORDATION CERTIFICATE
 Filing Requirement of Act 74, Mich. P.A. 1970

#2031962
 Liber 1540 Page 143
 Page 1 of 1
 Jackson Co., MI
 Recorded
 04/10/97 09:25A
 Mindy Reilly
 Register of Deeds

For corners in
JACKSON
 (County)

Located in: Corner Code #

1. Public Land Survey T1S R1E I-6
 T R
 T R
 T R

2. Property Controlling in Section S T R
 S T R

3. Miscellaneous Property in Sec. S T R
 S T R

4. Lot No. _____ Recorded Plat _____

5. Private Claims _____

SURVEY &
 REMONUMENTATION

APR 07 1998

SECTION

Register of Deeds Stamp & File Number

	A	B	C	D	E	F	G	H	I	J	K	L	M
1													
2	6	5	4	3	2	1							
3													
4	7	8	9	10	11	12							
5													
6	18	17	16	15	14	13							
7													
8	19	20	21	22	23	24							
9													
10	30	29	28	27	26	25							
11													
12	31	32	33	34	35	36							
13													

I, David E. Erickson, in a field survey on February 17, 1997, do hereby certify that under requirements of P.A. 74, Michigan P.A. of 1970, the corner points mentioned in lines 1 and 2 above were in conformance with regulations and rules therefore as required in the current manual of survey instructions of the United States Department of the Interior, Bureau of Land Management or by a decree of a Court of Law and/or that the corner points mentioned in lines 3, 4 and 5 above were in conformance with the rules of the Michigan Board of Land Surveyors or by a Decree of a Court of Law; established, re-established, monumented, re-monumented, recovered, found as expressed below:

NOTE: Not more than 4 corners, all in the same town and range, may be recorded on this certificate.

A. Description of original monument and accessories and/or subsequent restoration:

Around 1825, J. Wampler - Deputy Surveyor, set a "Post" and recorded one witness: "Tamarack 11, N74°W, 165" (108.90') and "No other tree near".

Around 1888, H.F. Bean reported "Post gone, one witness left" and recorded two witnesses: "Swp. Oak 12, S50 1/2°E, 243" (160.38') and "Willow 4, N29 1/2°E, 11 1/2" (7.59').

In 1990, R. Helsel - LS #18994, recorded the corner as "Clay cylinder" and noted four witnesses, per Land Corner Recordation Certificate (LCRC) at Liber 4, Page 196.

B. Description of corner evidence found and/or method applied in restoring or reestablishing corner:


Found bottom 7" of Fire Clay (FC) with capped iron #18657 (Fauser) on North side. Corner is 20' Southeast of 90° bend in drain. Accepted found FC as a careful and faithful perpetuation of the position of the original corner as remonumented by Bean. Set a 60" aluminum pipe with cap at position of found FC. Buried FC and iron on North side of monument.

C. Description of monument for corner and accessories established to perpetuate locating the position of the corner:

Set a 60" aluminum pipe with cap stamped "I-6, T1S-R1E, 1997, LS #29245".

N 39° E	Set nail & tag #29245, East side 20" Maple	33.07'
S 81° E	Set nail & tag #29245, North side 10" Oak	93.18'
S 66° E	Set nail & tag #29245, North side twin 10" Oak	25.76'
S 45° E	To face of 54" Oak (Possible Bean witness)	162.1'
S 58° W	Set nail and tag #29245, West side twin 15" Maple	71.87'
North	County Surveyor sign post	2.0'

NOTE: Bearings are magnetic

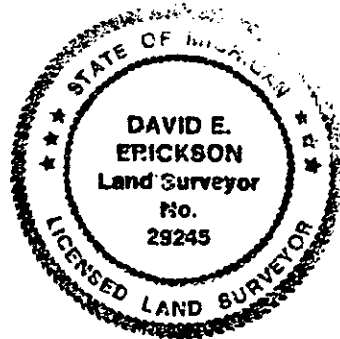

Signed by David E. Erickson Date 4-8-97

Surveyor's Michigan License No. 29245

FORM APPROVED BY MICHIGAN STATE BOARD OF LAND SURVEYORS, JAN. 28, 1971

REVISED MAY 14, 1975
 REVISED JAN. 1983
 ADAPTED FOR WORD PROCESSING MARCH, 1990

Record 281