

DAVID E. ERICKSON  
 Surveyor  
 Mar. 11, 1998

Center 1/4 Corner of Section 23, Henrietta Township  
**LAND CORNER RECORDATION CERTIFICATE**  
 Filing Requirement of Act 74, Mich. P.A. 1970

#2064435  
 Liber 1563 Page 981  
 Page 1 of 1  
 Jackson Co., MI  
 Recorded  
 03/12/1998 12:00P  
 Mindy Reilly  
 Register of Deeds

For corners in JACKSON (County)  
 Located In: \_\_\_\_\_ Corner Code # \_\_\_\_\_

1. Public Land Survey T1S R1E J-8  
 T \_\_\_\_\_ R \_\_\_\_\_  
 T \_\_\_\_\_ R \_\_\_\_\_  
 T \_\_\_\_\_ R \_\_\_\_\_

2. Property Controlling in Section S \_\_\_\_\_ T \_\_\_\_\_ R \_\_\_\_\_  
 S \_\_\_\_\_ T \_\_\_\_\_ R \_\_\_\_\_  
 S \_\_\_\_\_ T \_\_\_\_\_ R \_\_\_\_\_

3. Miscellaneous Property in Sec. S \_\_\_\_\_ T \_\_\_\_\_ R \_\_\_\_\_  
 S \_\_\_\_\_ T \_\_\_\_\_ R \_\_\_\_\_

4. Lot No. \_\_\_\_\_ Recorded Plat \_\_\_\_\_  
 5. Private Claims \_\_\_\_\_

**SURVEY & REMONUMENTATION**  
 SEP 16 1998  
 SECTION \_\_\_\_\_

Register of Deeds Stamp & File Number

	A	B	C	D	E	F	G	H	I	J	K	L	M
1													
2	6	5	4	3	2	1							
3													
4	7	8	9	10	11	12							
5													
6	18	17	16	15	14	13							
7													
8	19	20	21	22	24								
9													
10	30	29	28	27	26	25							
11													
12	31	32	33	34	35	36							
13													

I, David E. Erickson, in a field survey on November 13, 1997, do hereby certify that under requirements of P.A. 74, Michigan P.A. of 1970, the corner points mentioned in lines 1 and 2 above were in conformance with regulations and rules therefore as required in the current manual of survey instructions of the United States Department of the Interior, Bureau of Land Management or by a decree of a Court of Law and/or that the corner points mentioned in lines 3, 4 and 5 above were in conformance with the rules of the Michigan Board of Land Surveyors or by a Decree of a Court of Law, established, re-established, monumented, re-monumented, recovered, found as expressed below:

NOTE: Not more than 4 corners, all in the same town and range, may be recorded on this certificate.

A. Description of original monument and accessories and/or subsequent restoration:  
 This corner not set in original Government Survey.

Field notes obtained from Gutkunst Surveyors, indicate Fred Riley performed a survey for Carley in August of 1992. His notes show the Center of Section 23, but give no description of monument or witnesses.

Around 1988, an was set at the intersection of 1/4 lines by J.H. Miller. Several surveys by Miller were tied to this corner, as well as surveys by others. However, the wrong West 1/4 Corner was used to establish this position.

This corner has not been recorded under PA 74 of 1970.

B. Description of corner evidence found and/or method applied in restoring or reestablishing corner:

Searched area with backhoe. Found the capped iron set by Miller at surface of pavement, 7 feet South of an old fence line running East. Also found one, roundish, 12 inch diameter stone, down 12 inches. Stone is near road centerline and is in line with fence going East. No brick, pottery or iron was found by stone. I believe this stone is the un-named monument used in 1922. Rejected Miller corner due to establishment from incorrect corner and it's distance from occupation. Accepted stone as a careful and faithful establishment of the position of this corner, as used by Riley in 1922. Set a Harrison cast iron monument at exact location of found stone. Buried stone on East side of monument, down 2.7 feet. Reset a 1/2 rebar at location of Miller iron. Set monument box around monument with Jackson County Road Commission.


C. Description of monument for corner and accessories established to perpetuate locating the position of the corner:

Set a 30" long Harrison cast iron monument with Jackson County standard stamped "#29245".

N 01° E	Set nail and tag #29245, East side 28" Hickory County Surveyor sign post	218.36'
East	Set nail and tag #29245, South side fence corner post	23.8'
S 85° E	Set nail and tag #29245, West side 20" Walnut	31.04'
S 05° E	Set nail and tag #29245, East side fence post	168.44'
S 21° W	Set nail and tag #29245, East side fence post	95.78'
South	1/2 inch rebar reset at position of original Miller capped iron	5.05'
South	True intersection of 1/4 lines	6.94'

NOTE: Bearings are magnetic.

N00°12'10"E	Harrison monument at J-7 (Remonumentation corner)	2654.08'
S89°43'18"E	Concrete monument at K-8 (Remonumentation corner)	2661.24'
S00°12'12"W	Concrete monument at J-8 (Remonumentation corner)	2666.53'
S89°58'47"W	Concrete monument at I-8 (Remonumentation corner)	2665.40'

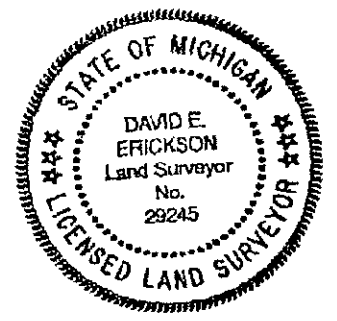

Signed by David E. Erickson Date 3-11-98  
 Surveyor's Michigan License No. 29245