

Chairman Don C. Matthews East 1/4 Corner of Section 14, Henrietta Township
Date APRIL 9, 1997
LAND CORNER RECORDATION CERTIFICATE
Filing Requirement of Act 74, Mich. P.A. 1970

#2031965
Liber 1540 Page 146
Page 1 of 1
Jackson Co., MI
Recorded
04/10/97 09:26A
Nindy Reilly
Register of Deeds

For corners in
JACKSON
(County)

Located In: _____ Corner Code # _____

1. Public Land Survey T1S R1E K-6
T _____ R _____
T _____ R _____
T _____ R _____

2. Property Controlling in Section S _____ T _____ R _____
S _____ T _____ R _____

3. Miscellaneous Property in Sec. S _____ T _____ R _____
S _____ T _____ R _____

4. Lot No. _____ Recorded Plat _____

5. Private Claims _____

SURVEY &
REMONUMENTATION
APR 07 1998
SECTION

Register of Deeds Stamp & File Number

	A	B	C	D	E	F	G	H	I	J	K	L	M
1													
2	6	5	4	3	2	1							
3													
4	7	8	9	10	11	12							
5													
6	18	17	16	15	14	13							
7													
8	19	20	21	22	23	24							
9													
10	30	29	28	27	26	25							
11													
12	31	32	33	34	35	36							
13													

I, David E. Erickson, in a field survey on March 12, 19 97, do hereby certify that under requirements of P.A. 74, Michigan P.A. of 1970, the corner points mentioned in lines 1 and 2 above were in conformance with regulations and rules therefore as required in the current manual of survey instructions of the United States Department of the Interior, Bureau of Land Management or by a decree of a Court of Law and/or that the corner points mentioned in lines 3, 4 and 5 above were in conformance with the rules of the Michigan Board of Land Surveyors or by a Decree of a Court of Law, established, re-established, monumented, re-monumented, recovered, found as expressed below:

NOTE: Not more than 4 corners, all in the same town and range, may be recorded on this certificate.

A. Description of original monument and accessories and/or subsequent restoration:

Around 1825, J. Wampler - Deputy Surveyor, reported the corner as "Set qr. Sec. post" and listed 2 witnesses: "B. Oak 8, S5°E, 40" (26.40') and "do 14, S39°W, 25" (16.50').

Around 1888, H.F. Bean, reported the corner as "Post gone, found remains of Witnesses." and lists 2 witnesses: "W. Oak 10, N75°W, 58 1/4" (38.44') and "B. Oak 2, N79°E, 6 1/2" (4.29').

In 1973, A.P. Kurzy - LS #14326, recorded the corner as "Found Pointed Stone with X on point 12" below Surface on NE side existing fence post, lying on side. Uprighted stone." and recorded 3 witnesses: "15" Oak South 30.0 ft to center; 8" Oak West 14.3 ft. to center; 15" Oak N50°W 15.0 ft. to center" per Land Corner Recordation Certificate (LCRC) recorded at Liber 2, Page 247, Jackson County Records.

B. Description of corner evidence found and/or method applied in restoring or reestablishing corner:


Found stone as recorded by Kurzy. Also found Fire Clay (FC) 0.3' below surface, in old East-West fence. Pieces of old fence running South. Accepted found FC as a careful and faithful perpetuation of the original corner position as remonumented by Bean. Stone by Kurzy not accepted. I believe stone is disturbed from same position as FC, probably having been over the FC at one time. Set a standard concrete monument at location of FC. Buried FC on North side of monument.

C. Description of monument for corner and accessories established to perpetuate locating the position of the corner:

Set a 4" diameter x 36" long concrete monument with cap stamped "K-6, T1S-R1E, 1997, LS #29245".

N 80° E	Stone recorded by Kurzy	2.07'
N 31° E	Set nail & tag #29245, Southeast side 10" Maple	22.70'
N 82° E	Set nail & tag #29245, North side 8" Maple	12.34'
S 79° E	Set nail & tag #29245, South side 18" Oak	51.04'
S 05° W	Set nail & tag #29245, East side 22" Oak	29.07'
N 40° W	Set nail & tag #29245, Northeast side 18" Oak	23.52'
West	Center of ditch to North	100'
North	South edge of ditch	55'
North	County Surveyor sign post	1.5'

NOTE: Bearings are magnetic

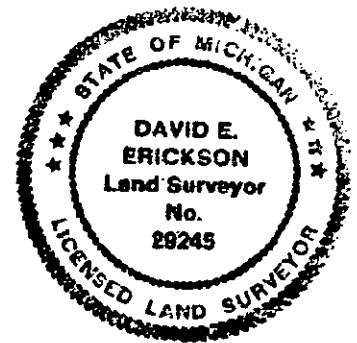

Signed by David E. Erickson Date 4-8-97

Surveyor's Michigan License No. 29245

Record 286