

P.A. 343 of 1970
 Chairman David Erickson Northeast Corner of Section 23, Henrietta Township
 Date Nov. 11, 1998
LAND CORNER RECORDATION CERTIFICATE
 Filing Requirement of Act 74, Mich. P.A. 1970

#2064436
 Liber 1563 Page 982
 Page 1 of 1
 Jackson Co., MI
 Recorded
 03/12/1998 12:00P
 Mindy Reilly
 Register of Deeds

For corners in
JACKSON
 (County)

Located In: Corner Code #

1. Public Land Survey	T <u>1</u> S R <u>1</u> E	<u>K-7</u>
	T _____ R _____	_____
	T _____ R _____	_____
	T _____ R _____	_____
2. Property Controlling in Section	S _____ T _____ R _____	_____
	S _____ T _____ R _____	_____
3. Miscellaneous Property in Sec.	S _____ T _____ R _____	_____
	S _____ T _____ R _____	_____
4. Lot No. _____ Recorded Plat _____		
5. Private Claims _____		

SURVEY & REMONUMENTATION

SEP 16 1998

Register of Deeds Stamp & File Number
SECTION

	A	B	C	D	E	F	G	H	I	J	K	L	M
1													
2	6	5	4	3	2	1							
3													
4	7	8	9	10	11	12							
5													
6	18	17	16	15	14	13							
7													
8	19	20	21	22	23	24							
9													
10	30	29	28	27	26	25							
11													
12	31	32	33	34	35	36							
13													

I, David E. Erickson, in a field survey on November 13, 19 97, do hereby certify that under requirements of P.A. 74, Michigan P.A. of 1970, the corner points mentioned in lines 1 and 2 above were in conformance with regulations and rules therefore as required in the current manual of survey instructions of the United States Department of the Interior, Bureau of Land Management or by a decree of a Court of Law and/or that the corner points mentioned in lines 3, 4 and 5 above were in conformance with the rules of the Michigan Board of Land Surveyors or by a Decree of a Court of Law, established, re-established, monumented, re-monumented, recovered, found as expressed below.

NOTE: Not more than 4 corners, all in the same town and range, may be recorded on this certificate.

A. Description of original monument and accessories and/or subsequent restoration:

Around 1825, Joseph Wampler - Deputy Surveyor, set a "Post" and recorded two witnesses: "B. Oak 9, N 22 1/2°E 6 1/2" (4.29') and "W. Oak 26, S 26 1/2°E, 6" (3.96').

Around 1888, H.F. Bean reported "Post gone. Found sight tree 637 South" and recorded two witnesses: "Elm 4, N71°E, 153 1/4" (101.14') and "W. Ash 2, S78°E, 193" (127.38').

In 1994, A.L. Schepelman recorded this corner in Liber 4, Page 268, as "found 1/2" rerod (cap #20707) on centerline E-W road."

B. Description of corner evidence found and/or method applied in restoring or reestablishing corner:


Found 1/2" x 22" rebar near road centerline, at surface. Surveys by Miller, Fauser, Hughes, Keller and Schepelman have utilized corner. Excavated area 25' E-W by 4'-8' wide, mostly West of found iron. Dug 4' deep in to 3' of sand. Area is at a driveway entrance to North and appears to be in a small road "cut". Found no other evidence of corner monument. Existing iron fits occupation North and South. Accepted iron as the best available evidence of the position of the original corner. Set a 30" long Harrison cast iron monument with cap at exact location of found iron.

C. Description of monument for corner and accessories established to perpetuate locating the position of the corner:

Set a 30" long Harrison cast iron monument with Jackson County standard cap stamped "#29245".

N 83° E	Set nail and tag #29245, South side 36" Walnut	114.41'
S 12° E	Set nail and tag #29245, West side power pole	27.76'
S 86° W	Set nail and tag #29245, North side 15" Hickory	134.83'
N 75° W	Set nail and tag #29245, South side 42" Oak	198.39'
S 10° W	County Surveyor sign post	23.7'

NOTE: Bearings are magnetic.

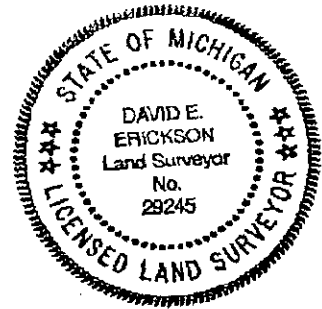

Signed by David E. Erickson Date 3-11-98

Surveyor's Michigan License No. 29245