 

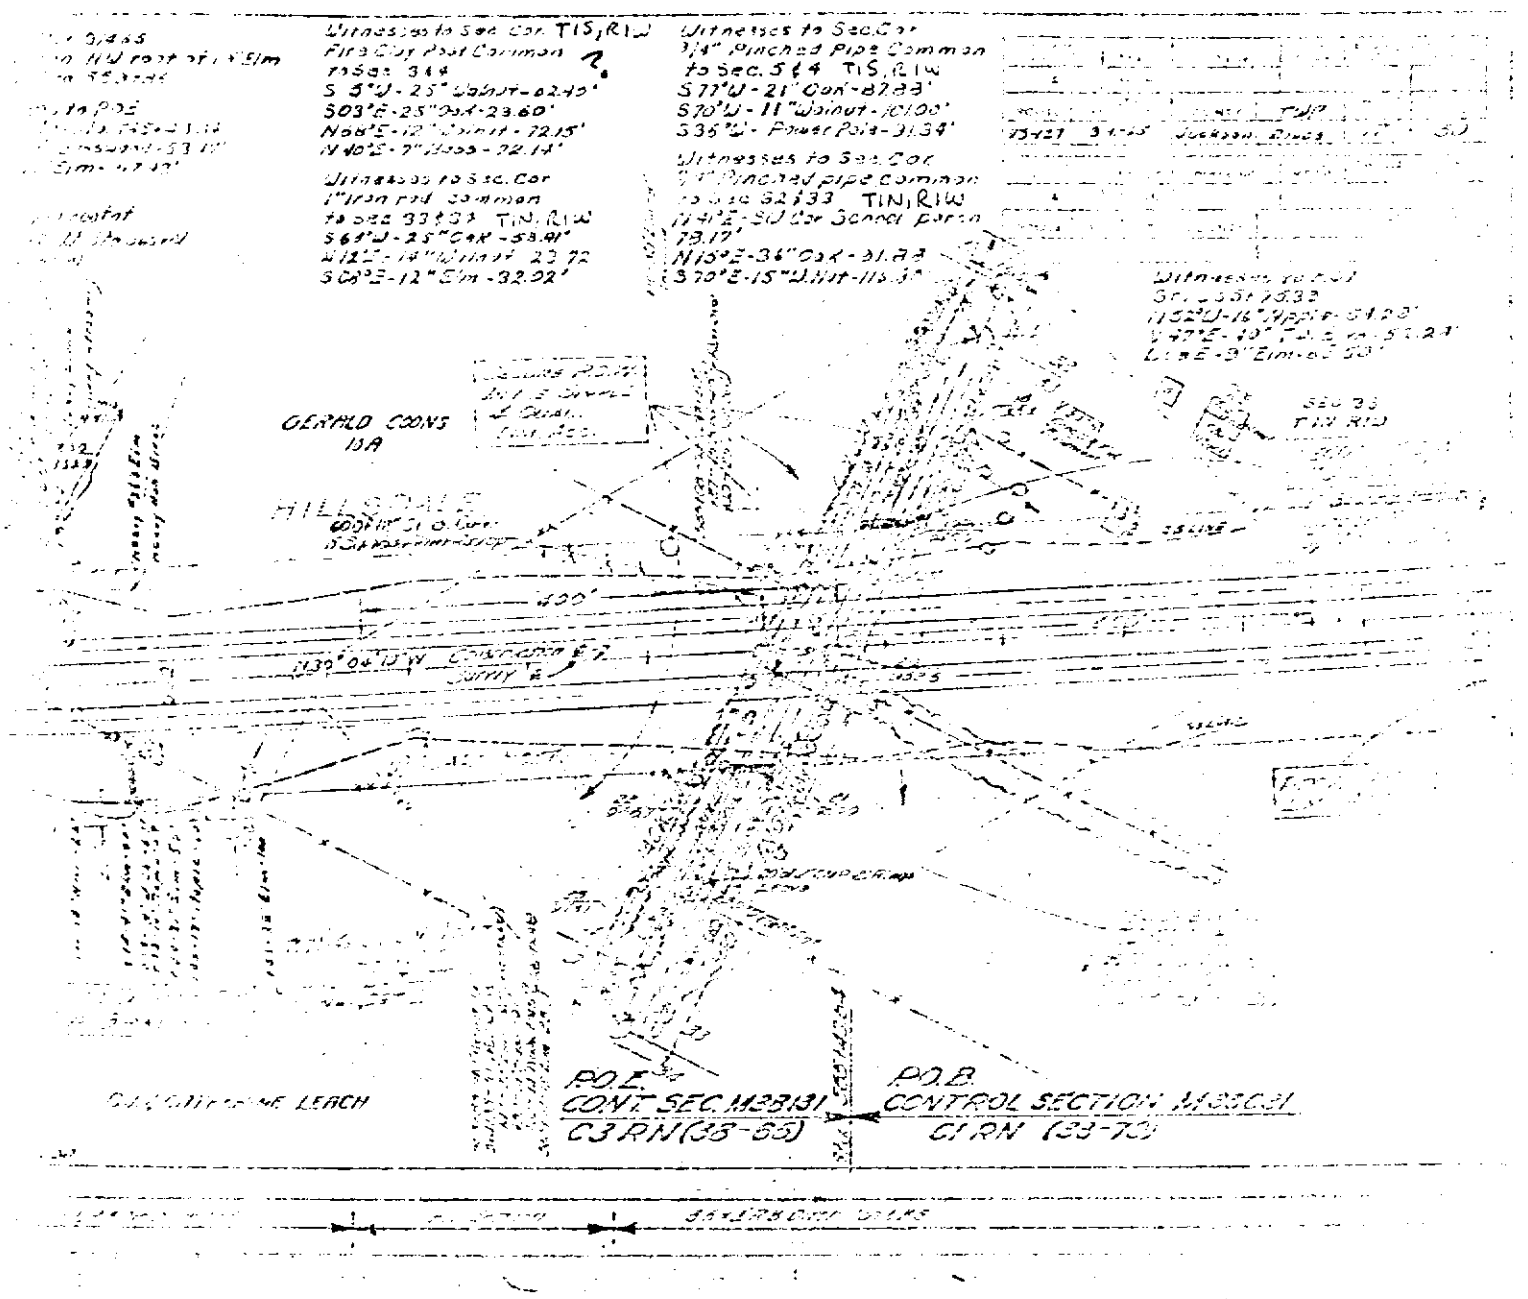

Witnesses to Sec. Cor. T1S, R1W
Fire Clay Post Common
to Sec. 3 & 4
S 5°W - 25" Walnut - 62.45'
S03°E - 25" Oak - 23.60'
N68°E - 12" Walnut - 72.15'
N40°E - 7" Hass - 72.14'
Witnesses to Sec. Cor
1" Iron rod common
to Sec. 33 & 34 T1N, R1W
S68°W - 25" Oak - 58.91'
N12°E - 14" Walnut 23.72
S08°E - 12" Elm - 32.02'
Witnesses to Sec. Cor
3/4" Pinched Pipe Common
to Sec. 5 & 4 T1S, R1W
S77°W - 21" Oak - 87.83'
S70°W - 11" Walnut - 101.00'
S35°W - Power Pole - 31.34'
Witnesses to Sec. Cor
Pinched pipe common
to Sec. 32 & 33 T1N, R1W
N15°E - 36" Oak - 31.88
S70°E - 15" Walnut - 115.3
GERALD COONS
10A
HILLSDALE
400'
N39°04'13"W
P.O.E.
CONT. SEC. M38131
C3 RN (38-65)
P.O.B.
CONTROL SECTION M38C31
C1 RN (38-70)