

Chairman Alan Scheppelman LAND CORNER RECORDATION CERTIFICATE

Date AUGUST 14, 1996 Filing Requirement of Act 74, Mich. P.A. 1970

#2021157
Liber 1532 Page 429
Page 1 of 1
Jackson Co., MI
Recorded
11/26/96 02:18P
Jerry McDevitt
Register of Deeds

Jackson <small>(County)</small>	Located In:	Corner Code #:
1. Public Land Survey	T <u>1S</u> R <u>1W</u>	<u>D-13</u>
	T _____ R _____	_____
	T _____ R _____	_____
	T _____ R _____	_____
2. Property Controlling in Section	S _____ T _____ R _____	_____
	S _____ T _____ R _____	_____
3. Miscellaneous Property in Sec.	S _____ T _____ R _____	_____
	S _____ T _____ R _____	_____
4. Lot No. _____, Recorded Plat _____		
5. Private Claims _____		

Register of Deeds Stamp & File Number

Alan L. Scheppelman in a field survey on June 20, 1996, do hereby certify that under requirements of P.A. 74, Michigan P.A. of 1970, the corner points mentioned in lines 1 and 2 above were in conformance with regulations and rules therefore as required in the current manual of survey instructions of the United States Department of the Interior, Bureau of Land Management or by a decree of a Court of Law and/or that the corner points mentioned in lines 3, 4 and 5 above were in conformance with the rules of the Michigan Board of Land Surveyors or by a Decree of a Court of Law; established, re-established, monumented, re-monumented, recovered, found as expressed below:

	A	B	C	D	E	F	G	H	I	J	K	L	M
2	6	5	4	3	2	1							
3													
4	7	8	9	10	11	12							
5													
6	18	17	16	15	14	13							
7													
8	19	20	21	22	23	24							
9													
10	30	29	28	27	26	25							
11													
12	31	32	33	34	35	36							
13													

NOTE: Not more than 4 corners, all in the same town and range, may be recorded on this certificate.

A. Description of original monument and accessories and/or subsequent restoration:


- JOSEPH WAMPLER, D.S. 1824** 40.00 SET QUARTER SECTION POST IN PRAIRIE W. OAK 16, N78 1/2 W, 69 LINKS (45.54') NO OTHER TREE CONVENIENT
- H.F. BEAN MAY-JULY 1885** ONE WITNESS LEFT, FOUND OLD STAKE HOLE. B. OAK 12, S 3E, 94 LINKS (62.04') SWP. OAK 8, S80W, 93 3/4 LINKS (61.88')

B. Description of corner evidence found and/or method applied in restoring or reestablishing corner:

FOUND FIRECLAY 0.3' ABOVE GROUND WITH 3/4" X 18" PIPE WITH CAP 7863 (RICHARD E. GUTEKUNST) AND IS 1' NORTH AND 2' EAST OF OLD FENCE CORNER THAT IS ROTTED. FOUND A 32" STUMP S5°E 45.5' THAT APPEARS TO BE BEAN'S FIRST WITNESS BUT IT MEASURES ONE ROD SHORT. ACCEPTED THE FIRECLAY AS A CAREFUL AND FAITHFUL PERPETUATION OF THE POSITION OF THE ORIGINAL CORNER AS REMONUMENTED BY BEAN. SET STANDARD JACKSON COUNTY MONUMENT AND BURIED THE FIRECLAY ON THE WEST SIDE AND PIPE ON THE EAST SIDE.

C. Description of monument for corner and accessories established to perpetuate locating the position of the corner:

- 4" X 36" CONCRETE MONUMENT WITH JACKSON COUNTY REMONUMENTATION CAP STAMPED "D-13 T1S R1W LS NO. 35998" IN MOUND OF STONES
- N65°E NAIL & TAG #35998 IN SE SIDE OF 9" HICKORY 46.21'
- S80°E NAIL & TAG #35998 IN N. SIDE OF 22" WHITE OAK 56.18'
- S15°W NAIL & TAG #35998 OVER 20d NAIL IN E. SIDE OF 12" HICKORY 17.92'
- N85°W NAIL & TAG #35998 OVER 60d NAIL IN N. SIDE OF 26" CHERRY 28.80'
- N32°W NAIL & TAG #35998 OVER 60d NAIL IN NE SIDE OF 18" CHERRY 46.81'
- N45°W NAIL & TAG #35998 OVER 20d NAIL IN SW SIDE OF 8" HICKORY 13.95'
- NORTH SURVEY MARKER SIGN & POST 1.4'

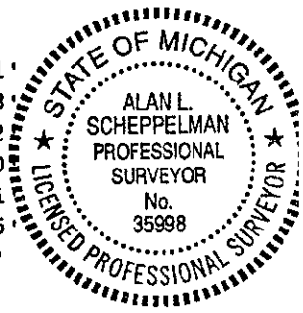

Signed by Alan L. Scheppelman Date 08/09/96
Surveyor's Michigan License No. 35998