

9700909

12/27

JACKSON COUNTY APPROVED LAND CORNER P.A. 345 of 1990

SOUTH 1/4 POST SECTION 26 NORVELL TOWNSHIP

ACTING Chairman Dean Enger

LAND CORNER RECORDATION CERTIFICATE Filing Requirement of Act 74, Mich. P.A. 1970

LIBER 1501 PAGE 1133

Date 12-27-1995 For corners in


JACKSON (County)

Located in: Corner Code 77

Table with 3 columns: Description (Public Land Survey, Property Controlling, Miscellaneous), T, R, and Corner Code (J-11).

STATE OF MICHIGAN JACKSON COUNTY REGISTERED 29 DEC 95 11:20 A.M. GERALD J. McDEVITT REGISTER OF DEEDS Register of Deeds Stamp & File Number

- 4. Lot No. Recorded Plat
5. Private Claims

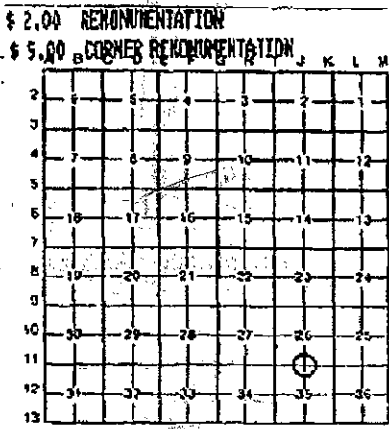

I, DEAN R. GUTEKUNST, in a field survey on November 22, 1995, do hereby certify that under requirements of P.A. 74, Michigan P.A. of 1970, the corner points mentioned in lines 1 and 2 above were in conformance with regulations and rules therefore as required in the current manual of survey instructions of the United States Department of the Interior, Bureau of Land Management or by a decree of a Court of Law and/or that the corner points mentioned in lines 3, 4 and 5 above were in conformance with the rules of the Michigan Board of Land Surveyors or by a Decree of a Court of Law, established, re-established, monumented, re-monumented, recovered, found as expressed below

NOTE: Not more than 4 corners, all in the same town and range, may be recorded on this certificate.

A Description of original monument and accessories and/or subsequent restoration

Original Government Post set by Hervey Parke, Deputy Surveyor, February 1824. W. Oak 16" N 8 E 37 links (24.42') 39.92' chains to 1/4 post. Y. Oak 18" S 10 W 57 links (37.52') 79.85 chains to Section corner. Perpetuation by B. F. LaRue, November 1884. W. Oak 8" S 8 3/4 W 23 1/2 links (15.51') Found Stone at corner and remains of both witnesses. * V. Oak 6" N 76 1/2 W 36 links (23.76') Fireclay (3" diameter X 24") lime under fireclay

Continued on back,

B Description of corner evidence found and/or method applied in restoring or reestablishing corner.

Found FIRECLAY, 6" below surface of Fishville Road (gravel). Found lime below fireclay. Corner is in line of fence West and hedge East and 7' West of center line of gravel. Accepted FIRECLAY, as a careful and faithful perpetuation of the position of the original corner, as re-monumented by LaRue in 1884. Set a Standard Jackson County Monument and left broken fireclay buried on North & South side of monument.

SURVEY & REMONUMENTATION

FEB 08 2000

SECTION

C Description of monument for corner and accessories established to perpetuate localizing the position of the corner.


J-11 T3S, R2E Corner is a 4" diameter X 36" concrete monument with a 1/2" X 36" steel rod and an aluminum cap stamped IS 18658, which is the standard monument for Jackson County.

Table with 4 columns: Marker description, Dimensions, and Distances. Includes items like 32" Oak, 22" W. Oak, 20" Sassafras, Double 1 1/2" Oak, Amoco Pipeline post, and Steel post with survey marker sign.

Signed by Dean R. Gutekunst

Date December 22, 1995

Surveyor's Michigan License No 18658

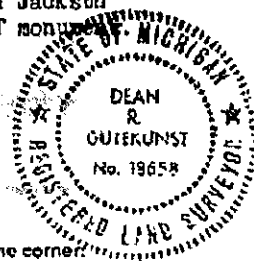

A. Continued,

- Perpetuation by Fred C. Riley, # 377, 1936
Fireclay, OK, top broken off
In line of fence East and 4" below surface
4.5' West of center line of traveled road.

** W. Oak 14" N 7°30'W 84.20'

- Not recorded in P. A. 74

SURVEY &
REMONUMENTATION

FEB 08 2000

SECTION