

JACKSON COUNTY
APPROVED LAND CORNER
P.A. 343 of 1990

Chairman Dean C. Falkner EAST 1/4 POST, SECTION 14, RIVES TOWNSHIP
 Date 9-10-97 **LAND CORNER RECORDATION CERTIFICATE**
 Filing Requirement of Act 74, Mich. P.A. 1970


#2050179
 Liber 1553 Page 411
 Page 1 of 1
 Jackson Co., MI
 Recorded
 10/15/97 12:52P
 Mindy Reilly
 Register of Deeds

For corners in
 Jackson

(County)	Located In:	Corner Code #
1. Public Land Survey	T <u>15</u> R <u>1W</u>	<u>K-6</u>
	T _____ R _____	_____
	T _____ R _____	_____
	T _____ R _____	_____
2. Property Controlling in Section	S _____ T _____ R _____	_____
	S _____ T _____ R _____	_____
3. Miscellaneous Property in Sec.	S _____ T _____ R _____	_____
	S _____ T _____ R _____	_____

Register of Deeds Stamp & File Number

4. Lot No. _____, Recorded Plat _____
 5. Private Claims _____

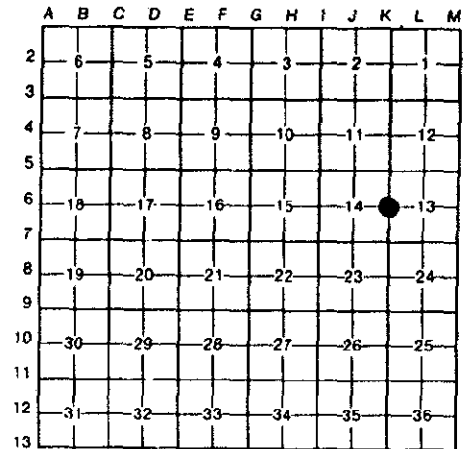

I, Alan L. Scheppelman, in a field survey on September 4, 1997, do hereby certify that under requirements of P.A. 74, Michigan P.A. of 1970, the corner points mentioned in lines 1 and 2 above were in conformance with regulations and rules therefore as required in the current manual of survey instructions of the United States Department of the Interior, Bureau of Land Management or by a decree of a Court of Law and/or that the corner points mentioned in lines 3, 4 and 5 above were in conformance with the rules of the Michigan Board of Land Surveyors or by a Decree of a Court of Law; established, re-established, monumented, re-monumented, recovered, found as expressed below:

NOTE: Not more than 4 corners, all in the same town and range, may be recorded on this certificate.

A. Description of original monument and accessories and/or subsequent restoration:

- HERVEY PARKE, D.S. 40.00 SET QUARTER SECTION POST
 MARCH 12, 1825 BLACK OAK 16, S65°E 57 LINKS (37.62')
 BLACK OAK 26, N85°W 70 LINKS (46.20')
- HENRY F. BEAN 1885 ONE GOOD WITNESS, FOUND STAKE HOLE
 YELLOW OAK 6, N64°W 9 LINKS (5.94')
 WHITE OAK 10 N84½°E 33 LINKS (21.78')

SURVEY & REMONUMENTATION

APR 07 1998


B. Description of corner evidence found and/or method applied in restoring or reestablishing corner:

SECTION

FOUND FIRECLAY FROM BEAN'S FIRST WITNESS AND THE DEPRESSION OF THE STUMP OF THE SECOND WITNESS. THE FIRECLAY WAS AT A DEPTH OF 1.2 FEET IN UNDISTURBED GROUND WITH A 10" DIAMETER STONE ON TOP OF IT. THE FIRECLAY WAS IN PERFECT CONDITION. ACCEPTED THE FIRECLAY AS A CAREFUL AND FAITHFUL PERPETUATION OF THE POSITION OF THE ORIGINAL CORNER AS REMONUMENTED BY BEAN. SET A 36" MONUMENT IN ITS PLACE AND BURIED THE FIRECLAY ON THE NORTH SIDE.

C. Description of monument for corner and accessories established to perpetuate locating the position of the corner:

- SET A 4" X 36" CONCRETE MONUMENT WITH A 1/2" X 36" REBAR AND JACKSON COUNTY REMONUMENTATION CAP STAMPED "K-6 T1S R1W LS NO. 35998"
- N40°E SET NAIL & TAG 35998 IN THE SE SIDE OF A 11" OAK 41.36'
- S45°E SET NAIL & TAG 35998 IN THE NE SIDE OF A 10" OAK 32.97'
- S05°W SET NAIL & TAG 35998 IN THE WEST SIDE OF A 15" OAK 41.10'
- S25°W SET NAIL & TAG 35998 IN THE WEST SIDE OF A 10" OAK 24.47'
- S60°W SET NAIL & TAG 35998 IN THE NORTH SIDE OF A 15" OAK 37.91'
- N65°W SET NAIL & TAG 35998 IN THE SOUTH SIDE OF A 34" OAK 5.55'
- NORTH SURVEY MARKER SIGN POST 1.95'

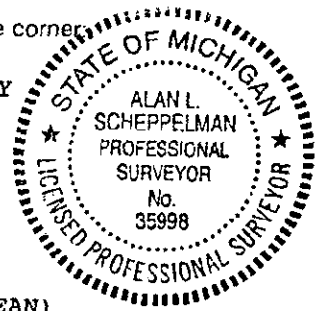

Signed by Alan L. Scheppelman Date 09/04/97
 Surveyor's Michigan License No. 35998

Record 245