

NORTHEAST CORNER, SECTION 36, RIVES TOWNSHIP

**LAND CORNER RECORDATION CERTIFICATE**  
**Filing Requirement of Act 74, Mich. P.A. 1970**

For corners in

Jackson  
 (County)

Located In:

Corner Code #

STATE OF MICHIGAN  
 JACKSON COUNTY  
 RECORDED

27 DEC 94 12:10 P.M.

GERALD J. McDEVITT  
 REGISTER OF DEEDS

Register of Deeds Stamp & File Number

|                                    |   |    |   |    |      |
|------------------------------------|---|----|---|----|------|
| 1. Public Land Survey              | T | 1S | R | 1W | M-11 |
|                                    | T |    | R |    |      |
|                                    | T |    | R |    |      |
|                                    | T |    | R |    |      |
| 2. Property Controlling in Section | S |    | T | R  |      |
|                                    | S |    | T | R  |      |
| 3. Miscellaneous Property in Sec.  | S |    | T | R  |      |
|                                    | S |    | T | R  |      |

4. Lot No. \_\_\_\_\_, Recorded Plat \_\_\_\_\_  
 5. Private Claims \_\_\_\_\_

|    |    |    |    |    |    |    |   |   |   |   |   |   |   |
|----|----|----|----|----|----|----|---|---|---|---|---|---|---|
|    | A  | B  | C  | D  | E  | F  | G | H | I | J | K | L | M |
| 2  | 6  | 5  | 4  | 3  | 2  | 1  |   |   |   |   |   |   |   |
| 3  |    |    |    |    |    |    |   |   |   |   |   |   |   |
| 4  | 7  | 8  | 9  | 10 | 11 | 12 |   |   |   |   |   |   |   |
| 5  |    |    |    |    |    |    |   |   |   |   |   |   |   |
| 6  | 18 | 17 | 16 | 15 | 14 | 13 |   |   |   |   |   |   |   |
| 7  |    |    |    |    |    |    |   |   |   |   |   |   |   |
| 8  | 19 | 20 | 21 | 22 | 23 | 24 |   |   |   |   |   |   |   |
| 9  |    |    |    |    |    |    |   |   |   |   |   |   |   |
| 10 | 30 | 29 | 28 | 27 | 26 | 25 |   |   |   |   |   |   |   |
| 11 |    |    |    |    |    |    |   |   |   |   |   |   |   |
| 12 | 31 | 32 | 33 | 34 | 35 | 36 |   |   |   |   |   |   |   |
| 13 |    |    |    |    |    |    |   |   |   |   |   |   |   |

I, Alan L. Scheppelman, in a field survey on October 19, 19 94, do hereby certify that under requirements of P.A. 74, Michigan P.A. of 1970, the corner points mentioned in lines 1 and 2 above were in conformance with regulations and rules therefore as required in the current manual of survey instructions of the United States Department of the Interior, Bureau of Land Management or by a decree of a Court of Law and/or that the corner points mentioned in lines 3, 4 and 5 above were in conformance with the rules of the Michigan Board of Land Surveyors or by a Decree of a Court of Law; established, re-established, monumented, re-monumented, recovered, found as expressed below.

**NOTE: Not more than 4 corners, all in the same town and range, may be recorded on this certificate.**

A. Description of original monument and accessories and/or subsequent restoration:

JOSEPH POST SET IN ORIGINAL GOVERNMENT SURVEY  
 WAMPLER TAM. 9, S36°W, 48 LINKS (31.7')  
 1824 TAM. 5, N37°E, 63 LINKS (41.6')  
 H.F. BEAN FOUND POST AND BOTH WITNESSES  
 1885 TAMARACK 3, S40½°W, 238½ LINKS (157.4')  
 GLENN SURVEY RECORDED NOV. 18, 1988 - L. 1184, P. 524  
 FAUSER FOUND 1/2" REBAR AT FENCE CORNER, NO WITNESSES GIVEN  
 SEPT., 1988

**JACKSON COUNTY**  
**APPROVED LAND CORNER**  
**P.A. 343 of 1990**  
 Chairman Reginald Stalham  
 Date NOV. 10, 1994


B. Description of corner evidence found and/or method applied in restoring or reestablishing corner:

FOUND FIRECLAY LEANING (NEARLY LYING DOWN) NW'LY.  
 I DUG 1' BELOW GROUND AT THE BASE OF THE FIRECLAY AND FOUND A FENCE POST WITH STONES AROUND IT. THE FIRECLAY SEEMS TO HAVE BEEN REMOVED (WHEN THE FENCE POST WAS PUT IN) AND RESET ON THE NORTH SIDE OF FENCE POST. THE FIRECLAY AND FENCE POST WERE ACCEPTED AS A PERPETUATION OF THE POSITION OF THE ORIGINAL CORNER AS REMONUMENTED IN 1885. SET A 1" X 60" ALUM. PIPE WITH A JACKSON COUNTY REMONUMENTATION CAP STAMPED LS35998 ON THE NORTH SIDE OF THE FENCE POST AND BURIED THE FIRECLAY ON THE NORTH SIDE. THIS LOCATION IS 2' EAST OF AN EXISTING N-S FENCE AND 2' SOUTH OF A FENCE TO THE WEST. I DID NOT FIND THE 1/2" REBAR AT THE FENCE CORNER AS RECORDED BY GLENN FAUSER IN 1988.

\$ 2.00 REMONUMENTATION  
 \$ 7.00 CORNER REMONUMENTATION

C. Description of monument for corner and accessories established to perpetuate locating the position of the corner:

1" X 60" ALUM. PIPE WITH JACKSON COUNTY REMONUMENTATION CAP STAMPED LS35998  
 S80°W 8' "T" FENCE POST 1.65'  
 N40°W RR RAIL FENCE POST (BASE) 4.0'  
 N45°W 20d NAIL & RAISED SHINER IN E. SIDE OF 6" MAPLE 48.91'  
 N30°E 20d NAIL & RAISED SHINER IN SE SIDE OF 12" ELM 88.49'  
 N70°E 20d NAIL & RAISED SHINER IN N. SIDE OF 10" ASH 178.30'  
 S10°E 20d NAIL & RAISED SHINER IN E. SIDE OF 8" ELM 18.92'

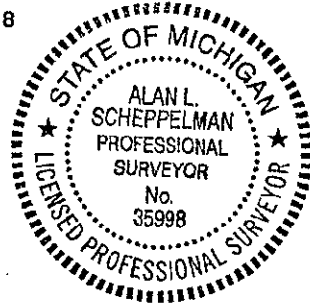

Signed by Alan L. Scheppelman Date 10/25/94  
 Surveyor's Michigan License No. 35998