

Chairman Alan L. Schepelman
 Date Dec. 27, 1994

LAND CORNER RECORDATION CERTIFICATE
 Filing Requirement of Act 74, Mich. P.A. 1970

For corners in

Jackson (County)	Located In:	Corner Code #
1. Public Land Survey	T 1S R 1W	M-13
	T ___ R ___	_____
	T ___ R ___	_____
	T ___ R ___	_____
2. Property Controlling in Section	S ___ T ___ R ___	_____
	S ___ T ___ R ___	_____
3. Miscellaneous Property in Sec.	S ___ T ___ R ___	_____
	S ___ T ___ R ___	_____

STATE OF MICHIGAN
 JACKSON COUNTY
 RECORDED
 27 DEC 94 12:11 P.M.
 GERALD J. McDEVITT
 REGISTER OF DEEDS
 Register of Deeds Stamp & File Number

4. Lot No. _____, Recorded Plat _____
 5. Private Claims _____

	A	B	C	D	E	F	G	H	I	J	K	L	M
2	6		5		4		3		2		1		
3													
4	7		8		9		10		11		12		
5													
6	18		17		16		15		14		13		
7													
8	19		20		21		22		23		24		
9													
10	30		29		28		27		26		25		
11													
12	31		32		33		34		35		36		
13													

I, Alan L. Schepelman in a field survey on December 22, 19 94, do hereby certify that under requirements of P.A. 74, Michigan P.A. of 1970, the corner points mentioned in lines 1 and 2 above were in conformance with regulations and rules therefore as required in the current manual of survey instructions of the United States Department of the Interior, Bureau of Land Management or by a decree of a Court of Law and/or that the corner points mentioned in lines 3, 4 and 5 above were in conformance with the rules of the Michigan Board of Land Surveyors or by a Decree of a Court of Law; established, re-established, monumented, re-monumented, recovered, found as expressed below:


NOTE: Not more than 4 corners, all in the same town and range, may be recorded on this certificate.

A. Description of original monument and accessories and/or subsequent restoration:

- JOSEPH POST SET IN ORIGINAL GOVERNMENT SURVEY.
 WAMPLER W. OAK 15, S65°W, 128 LINKS (84.48') \$ 2.00 REMONUMENTATION
 JAN., 1824 ELM 16, N41½°W, 158 LINKS (104.28') \$ 7.00 CORNER REMONUMENTATION
- H.F. BEAN FOUND POST AND REMAINS OF WITNESSES.
 1885 J. OAK 8, S86°W, 151 LINKS (99.66')
- JOHN FOUND ONE WITNESS STUMP FOR BLACKMAN CORNER
 HOLCROFT SET BY H.F. BEAN FOR RIVES.
 JULY 1, 1886 Y. OAK 8, S86°W, 151 LINKS (99.66')

B. Description of corner evidence found and/or method applied in restoring or reestablishing corner:

FOUND TOP 15" OF FIRECLAY LYING ON GROUND (TOP OF BANK). I DID NOT FIND THE BOTTOM PORTION OF THE FIRECLAY. THE POSITION OF THE CORNER IS CONSIDERED LOST BECAUSE IT FALLS ALONG A DRAIN (COURSE S-NNE) THAT WAS PUT IN AROUND 1945. A PROPERTY OWNER THAT HAS LIVED THERE SINCE 1941 SAID THE DRAIN IS CENTERED ON THE OLD FENCE LINE. M-13 WAS SET AT THE CLOSING DISTANCE FROM A-13 AND EXTENDED SOUTH FROM M-11. SET A STANDARD JACKSON COUNTY MONUMENT AND BURIED THE TOP PORTION OF THE FIRECLAY ON THE NORTH SIDE.

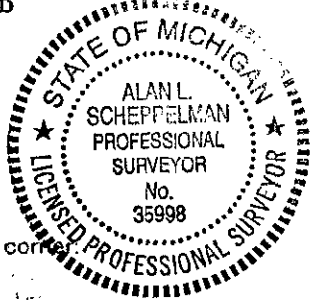

C. Description of monument for corner and accessories established to perpetuate locating the position of the corner:

- M-13 4" x 36" CONCRETE MONUMENT WITH JACKSON COUNTY REMONUMENTATION CAP STAMPED LS35998 AT TOP OF WEST BANK OF DRAIN.
- | | | |
|-------|---|---------|
| WEST | 20d NAIL & RAISED SHINER IN S. SIDE DBL 14" CHERRY | 115.45' |
| N60°W | 20d NAIL & RAISED SHINER IN S. SIDE 26" ASH | 38.13' |
| N30°E | 20d NAIL & RAISED SHINER IN W. SIDE 14" CHERRY | 4.28' |
| N20°E | 20d NAIL & RAISED SHINER IN W. SIDE DBL 6" & 10" COTTONWOOD | 49.93' |

Signed by Alan L. Schepelman Date 12/23/94
 Surveyor's Michigan License No. 35998