


STATE OF MICHIGAN
DEPARTMENT
OF
NATURAL RESOURCES

LAND CORNER RECORD

JACKSON COUNTY
T 15 R 2E


DESCRIPTION OF CORNER WEST 1/4 CORNER SEC. 10
CORNER MONUMENT 3/4" x 30" IRON PIPE
DATE MONUMENT PLACED AND WITNESSED 3/31/69
WITNESSES TO CORNER..... N 60° W 21.6' SIGN POST

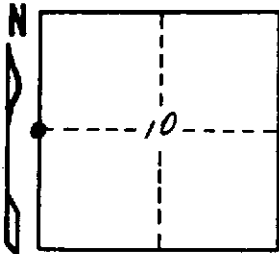

NORTH 106.5' TO 12" C.M.P.
S 80° E 106.5' TO 40" WILLOW P.K. NAIL + BRASS TAG
AND

CIRCLE CORNER REGISTERED

DESCRIPTION IN DETAIL AS TO HOW CORNER WAS LOCATED AND IDENTIFIED OR RESTORED.

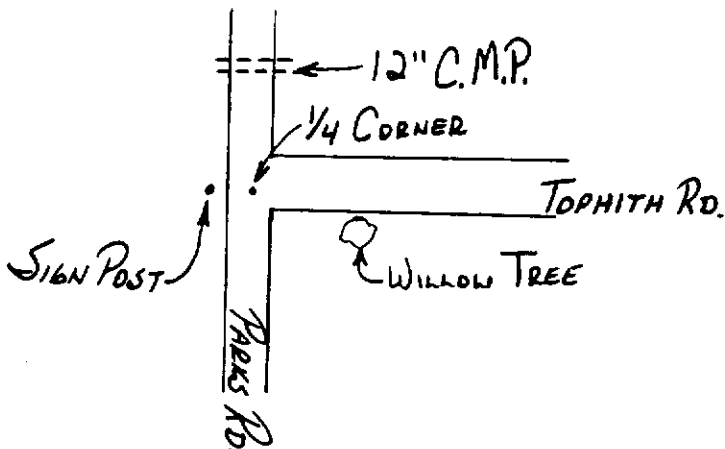

SURVEYOR'S SEAL

SIGNED

[Signature]
REGISTERED LAND SURVEYOR

DATE

4/1/69

DISTRIBUTION:

County Courthouse
Area Forester (Regions I & II)
District or Region Surveyor
Forestry Div., Lansing