


STATE OF MICHIGAN
DEPARTMENT
OF
NATURAL RESOURCES

LAND CORNER RECORD

JACKSON COUNTY
T 15 R 2E

DESCRIPTION OF CORNER NORTH 1/4 CORNER SEC. 10
CORNER MONUMENT SET 3/4" x 30" IRON PIPE AT FENCE CORNER POST SURROUNDED WITH STONES
DATE MONUMENT PLACED AND WITNESSED 3/31/69 FENCE INTERSECTIONS E.W. & N. FENCES
WITNESSES TO CORNER..... S 54° E 6.95' 7" OAK PK NAIL & BRASS TAG

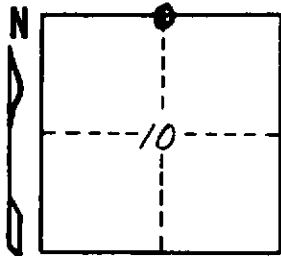


N 14° W 25.4' 28" OAK PK NAIL & BRASS TAG

NORTH 45.2' 28" OAK PK NAIL & BRASS TAG

AND

CIRCLE CORNER REGISTERED

DESCRIPTION IN DETAIL AS TO HOW CORNER WAS LOCATED AND IDENTIFIED OR RESTORED.

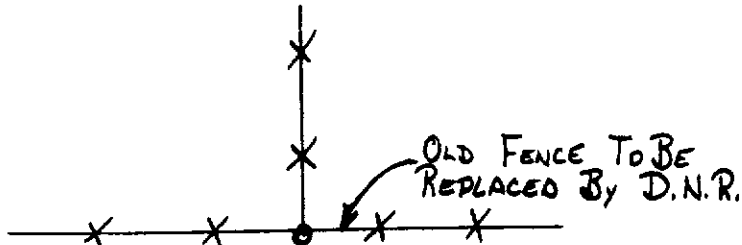

SURVEYOR'S SEAL

SIGNED

[Signature]
REGISTERED LAND SURVEYOR

DATE

4/1/69

DISTRIBUTION:

County Courthouse
Area Forester (Regions I & II)
District or Region Surveyor
Forestry Div., Lansing