


STATE OF MICHIGAN
DEPARTMENT
OF
NATURAL RESOURCES

LAND CORNER RECORD

JACKSON COUNTY
T 15 R 2 E


DESCRIPTION OF CORNER SOUTHWEST CORNER SEC. 10
CORNER MONUMENT 3/4" IRON PIPE
DATE MONUMENT PLACED AND WITNESSED 3/31/69
WITNESSES TO CORNER..... S 32° W 99.7' TO N.E. CORNER OF BARN

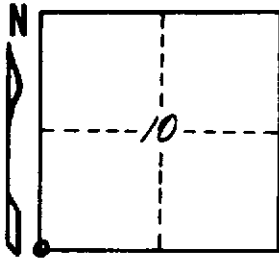

S 34° E 32.58' TO TELEPHONE POLE PK NAIL & BRASS TAG
S 65° W 31.6' TO FENCE CORNER POST
AND

CIRCLE CORNER REGISTERED

DESCRIPTION IN DETAIL AS TO HOW CORNER WAS LOCATED AND IDENTIFIED OR RESTORED.

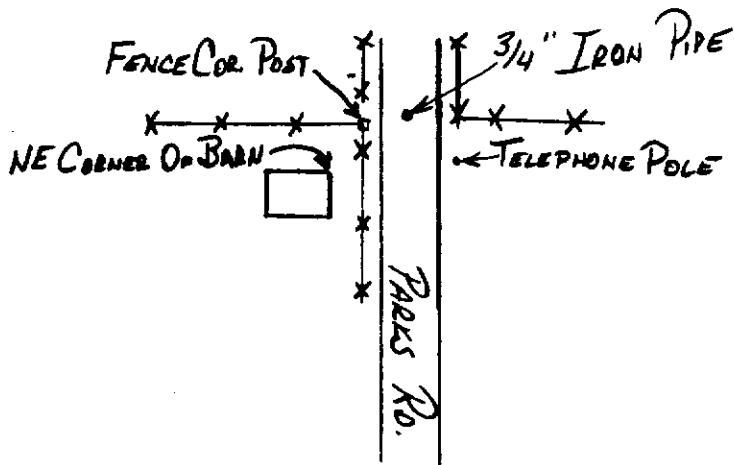

SURVEYOR'S SEAL

SIGNED

[Signature]
REGISTERED LAND SURVEYOR

DATE

4/1/69

DISTRIBUTION:

County Courthouse
Area Forester (Regions I & II)
District or Region Surveyor
Forestry Div., Lansing

R 4047
Rev. 10/68