

STATE OF MICHIGAN
DEPARTMENT
OF
NATURAL RESOURCES

LAND CORNER RECORD


JACKSON COUNTY
T 16 R 2E

DESCRIPTION OF CORNER WEST 1/4 CORNER SEC. 15

CORNER MONUMENT 3/4" PINCHED IRON PIPE

DATE MONUMENT PLACED AND WITNESSED 3/31/69

WITNESSES TO CORNER..... N 69° E 27.9' TWIN 7" HICKORY SPIKE + METAL TAG

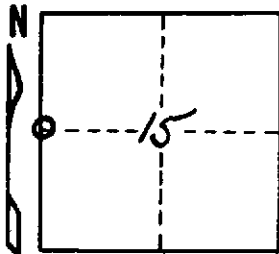


N 10° W 88.7' 28" DEAD ELM SPIKE + TAG

S 30° W 50.6' 26" OAK SPIKE + METAL TAG

AND

CIRCLE CORNER REGISTERED

DESCRIPTION IN DETAIL AS TO HOW CORNER WAS LOCATED AND IDENTIFIED OR RESTORED.

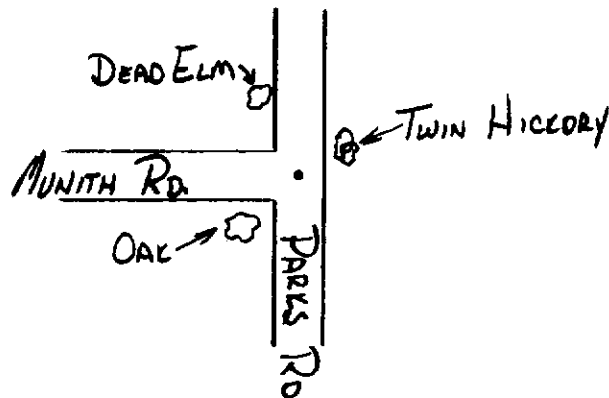

SURVEYOR'S SEAL

SIGNED [Signature]
REGISTERED LAND SURVEYOR

DATE 4/1/69

DISTRIBUTION:

County Courthouse
Area Forester (Regions I & II)
District or Region Surveyor
Forestry Div., Lansing