

STATE OF MICHIGAN
DEPARTMENT
OF
NATURAL RESOURCES

LAND CORNER RECORD

Jackson COUNTY


T 15. R 2E.

DESCRIPTION OF CORNER East 1/4 Corner Sec. 10. T. 15. R. 2E.

CORNER MONUMENT Set 3/4" X 30" Iron Pipe

DATE MONUMENT PLACED AND WITNESSED Set & Witnessed 3-20-69

WITNESSES TO CORNER..... North 5.0' Edge of Gravel

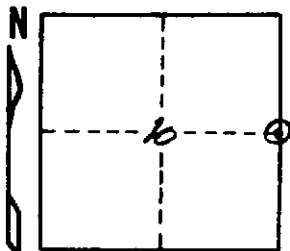


West 50.4' Center 24" C.M.P.

South 134.9' 30" oak with P.K. nail & tag

AND
S. 80° E. 237.8 26" oak (one of a group
of five) P.K. Nail & tag Set in S. side of NW trees

CIRCLE CORNER REGISTERED
DESCRIPTION IN DETAIL AS TO HOW CORNER WAS LOCATED AND IDENTIFIED OR RESTORED.

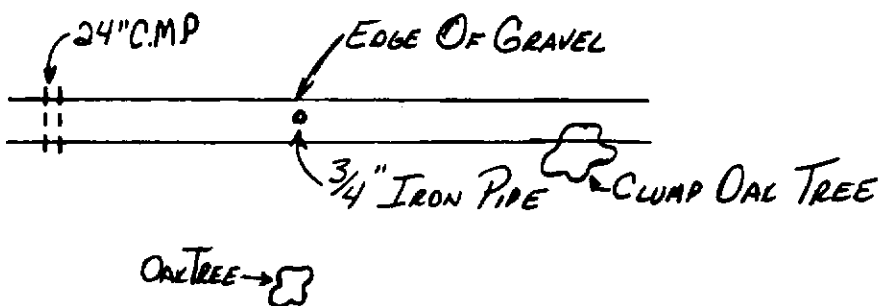

SURVEYOR'S SEAL

SIGNED

[Signature]
REGISTERED LAND SURVEYOR

DATE

4/1/69

DISTRIBUTION:

County Courthouse
Area Forester (Regions I & II)
District or Region Surveyor
Forestry Div., Lansing