


STATE OF MICHIGAN
DEPARTMENT
OF
NATURAL RESOURCES

LAND CORNER RECORD

JACKSON COUNTY
T 15 R 2E


DESCRIPTION OF CORNER SOUTHEAST CORNER SEC. 10
CORNER MONUMENT 3/4" x 30" IRON PIPE
DATE MONUMENT PLACED AND WITNESSED 3/31/69
WITNESSES TO CORNER..... S 61° E 27.1' 6" OAK PK NAIL + BRASS TAG

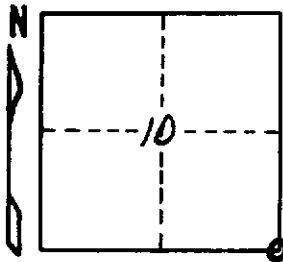

S 26° W 26.8' 6" TAMARAC PK NAIL + BRASS TAG
N 62° W 31.1' 7" TAMARAC PK NAIL + BRASS TAG
AND

CIRCLE CORNER REGISTERED

DESCRIPTION IN DETAIL AS TO HOW CORNER WAS LOCATED AND IDENTIFIED OR RESTORED.

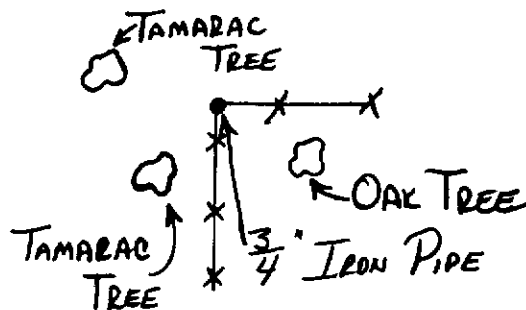

SURVEYOR'S SEAL

SIGNED


REGISTERED LAND SURVEYOR

DATE

4/1/69

DISTRIBUTION:

County Courthouse
Area Forester (Regions I & II)
District or Region Surveyor
Forestry Div., Lansing