SEE JACKSON CO
MISC #6 G.L.O. DATA

$\frac{2655.69}{2640.00} = \frac{L}{990.00}$
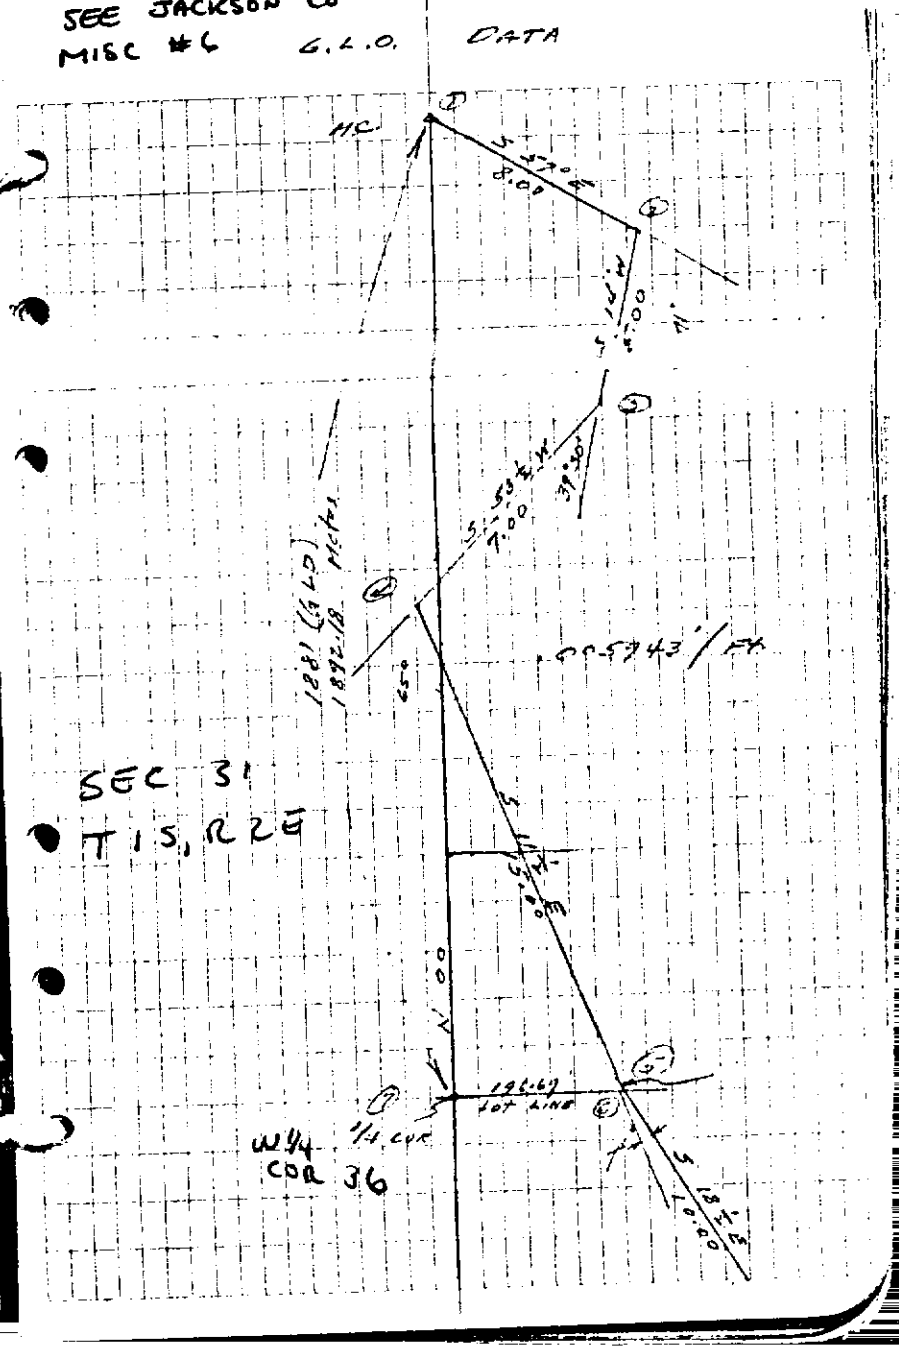
$L = 995.88'$ M.C. #4 to M.C. #5