


Plotting

TIE IN OF SEC COR. COMPANION TO  
19-20-30-29 T 15 R 2 E  
Post. 1A K Traverse 4/22/30  
STATION

STONE H.C.  
CARDON R.  
STATION

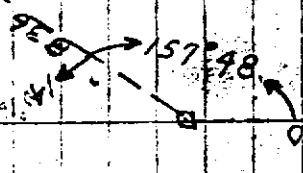

580  
1599.02  
217908

580  
1599.02  
217908

1599.02  
N 68° 45' W

IRON PIPE

4-27-30  
Coop  
Heppner  
Stone  
Cardone

L-9

NE COR. 25

SEC COR. COMPANION TO 24x25  
T 15 R 2 E

We dug & found a Fire Clay  
post 1' below surface in the  
apparent intersection of Rd.  
& Stone Myer's. This was below  
a field stone.

Made witnesses as follows:

- N 49° E Fe Cor post in Conc. 49.0'
- N 12° E 10" Cherry 130.276'
- N 65° W 12" Maple 101.486'
- N 15° NE 4" Elm 101.062'
- S 15° E Stump of tree 1/2 S.D. 30.466'

From: 19-20-30-29