

# LAND CORNER RECORDATION CERTIFICATE

## FILING REQUIREMENT OF ACT 74, MICH. P.A. 1970

*Jackson Co*

FOR CORNERS OF--:	LOCATED IN--:	CORNER CODE NUMBER
1. PUBLIC LAND SURVEY <u>35</u> T. <u>1</u> S., R. <u>2</u> E.		J-11
2. PROPERTY CONTROLLING IN SECTION _____, T. _____ S., R. _____ E.		
3. MISCELLANEOUS PROPERTY IN SECTION _____, T. _____ S., R. _____ E.		
4. LOT NO. _____, RECORDED PLAT _____		
5. PRIVATE CLAIMS _____		

REGISTER OF DEEDS STAMP AND FILING NUMBER

I, Donald L. Bissell, do hereby certify that under requirements of P.A. 74, Michigan P.A. of 1970, the corner points mentioned in lines 1 and 2 above were, in a field survey on January, 19 85, established, re-established, monumented, re-monumented, recovered or restored as expressed below and in conformance with regulations and rules therefore as required in the current manual of survey instructions of the United States Department of the Interior, Bureau of Land Management or by a decree of a court of law. Furthermore, that the corner points mentioned in lines 3, 4 and 5 above were, in a field survey on \_\_\_\_\_, 19\_\_\_\_, found, recovered, restored, established or re-established as expressed below and in conformance with the rules of the Michigan State Board of Registration for Land Surveyors or, by a Decree of a Court of law:

**A. Description of original monument and accessories and/or subsequent restoration:**

J-11 ¼ Cor. between Sec. 26 & 35	1921 witnesses
G.L.O. witnesses 1825	8" Swamp Oak - N82°E - 57.5
15" W. Oak - N 89°E - 90 lks.	12" Hickory - S+ 35°W - 104.4
9" W. Oak - S 2°E - 83 lks.	32" W. Oak - S 2°E - 83 lks. (Now 53.8)

**B. Description of corner evidence found and/or method applied in restoring or re-establishing corner:**

J-11 ¼ Cor. between Sec. 26 & 35  
 1921 Survey  
 Fd. old stake in swamp - 18" water, placed 8' swamp oak  
 Stake - 4" dia. square end in place, Dec. 1984 fd. 8' swamp oak  
 Stake with 1921 witnesses 12" Hickory - S35°W - 104.4' (found old blaze)  
 32" W. Oak - S2°E - 53.8' (Now stump)  
 Replaced 8' oak stake with 4" x 10' plastic pipe w/ 1" iron pipe w/alum. cap.

**C. Description of monument for corner and accessories established to perpetuate locating the position of the corner:**

J-11 ¼ Cor. between Sec. 26 & 35  
 4" x 10' plastic pipe with 1" iron pipe and alum. cap inside and filled with conc., in swamp.  
 S35°W - 104.78' - 14" Hickory, large blaze (1921 wit.)  
 S44°W - 94.93' - 7" R. Cedar  
 S29°E - 41.81' - 12" Swamp Oak  
 S80°E - 29.55' - 4" Oak  
 S 2°E - 53.7' - 30" Oak Stump (1825 & 1921 witness)


SIGNED BY \_\_\_\_\_ DATE \_\_\_\_\_

SURVEYOR'S MICHIGAN REGISTRATION NO. \_\_\_\_\_

FOR STATE AND UNITED STATES AGENCIES:

SIGNED BY \_\_\_\_\_ DATE \_\_\_\_\_

APPROVED AND SIGNED BY Donald L. Bissell DATE \_\_\_\_\_  
MICHIGAN REGISTERED LAND SURVEYOR

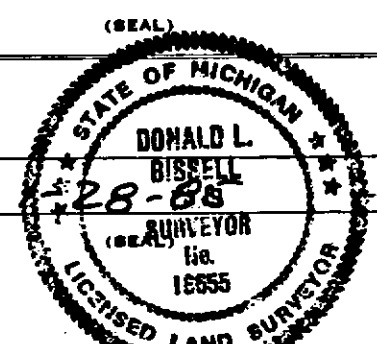

SURVEYOR'S MICHIGAN REGISTRATION NO. 18655