

JACKSON COUNTY
APPROVED LAND CORNER
P.A. 345 of 1996
 ACTING
 Chairman
 Timothy B. Duggan
 Date 8-13-97

NORTHWEST CORNER, SECTION 6
 WATERLOO TOWNSHIP

DUPLICATE OF CORNER
 RECORDED IN LIBER 1549
 PAGE 135, for the
 Northeast corner of
 Section 1, Henrietta
 Township.

LAND CORNER RECORDATION CERTIFICATE
 Filing Requirement of Act 74, Mich. P.A. 1970

For corners in
JACKSON
 (County)

Located In: _____ Corner Code ~~##~~

1. Public Land Survey T 1 S 2 R 2 E A-1
 T _____ R _____
 T _____ R _____
 T _____ R _____
2. Property Controlling S _____ T _____ R _____
 in Section S _____ T _____ R _____
3. Miscellaneous S _____ T _____ R _____
 Property in Sec. S _____ T _____ R _____

#2056281
 Liber 1557 Page 1017
 Page 1 of 2
 Jackson Co., MI
 Recorded
 12/17/1997 03:48P
 Mindy Reilly
 Register of Deeds

Register of Deeds Stamp & File Number

4. Lot No. _____, Recorded Plat _____ SECTION _____
 5. Private Claims _____

I, DEAN R. GUTEKUNST, in a field survey on July 15, 1996 & June 16, 1997, do hereby certify that under requirements of P.A. 74, Michigan P.A. of 1970, the corner points mentioned in lines 1 and 2 above were in conformance with regulations and rules therefore as required in the current manual of survey instructions of the United States Department of the Interior, Bureau of Land Management or by a decree of a Court of Law and/or that the corner points mentioned in lines 3, 4 and 5 above were in conformance with the rules of the Michigan Board of Land Surveyors or by a Decree of a Court of Law; established, re-established, monumented, re-monumented, recovered, found as expressed below:

NOTE: Not more than 4 corners, all in the same town and range, may be recorded on this certificate.

	A	B	C	D	E	F	G	H	I	J	K	L	M
2	6	5	4	3	2	1							
3													
4	7	8	9	10	11	12							
5													
6	13	17	16	15	14	13							
7													
8	19	20	21	22	23	24							
9													
10	30	29	28	27	26	25							
11													
12	31	32	33	34	35	36							
13													

A. Description of original monument and accessories and/or subsequent restoration:

Original Government Post set by Joseph Wampler, Deputy Surveyor, 1824.
 Elm 16" S 32 W 324 links (213.84') 89.93 Intersect Base Line at
 W. Oak 20" S 7 E 336 links (221.76') old corner in prairie.
 Perpetuation by H. F. Bean, 1888.
 W. Oak 40" S 7 E (US) 334 1/2 links (220.77') Post gone, one good witness left.
 Elm 10" N 35 1/2 W 298 links (196.68')

Continued on back,

B. Description of corner evidence found and/or method applied in restoring or reestablishing corner:

Found a 1/2" rerod at surface of Base Line Road (gravel). Also found a "T" iron 3.35' directly North of rerod. Also found the bottom 8" of a Fireclay, lying almost flat, approximately 5.4' North of rerod and 0.5' West of line of rerod and "T" iron.

Backhoe excavation of area did not reveal any additional evidence of corner.

Accepted rerod and "T" iron for East & West position of corner, and set monument on the South line of Section 31, Town 1 North, Range 2 East, between the Southwest corner and South 1/4 Post of Section 31, both of which were concrete monuments. This point is 0.25' North of position of rerod found and 3.1' South of "T" iron found.

Accepted this location as the best position for the corner.

Corner is approximately 3' South of center line of Base Line Road (blacktop) and in line with occupation running South.

Set a Standard Jackson County Monument for the corner.

C. Description of monument for corner and accessories established to perpetuate locating the position of the corner:

A-1 T1S, R2E Corner is a 4" diameter X 30" Cast Iron Harrison monument with a brass cap stamped LS 18658, which is a standard monument for Jackson County.

S 80° E 13" Pine 121.29' Pole barn spike and washer on North side.

South - "X" cut on top of metal sulvert, 6" in from West end 27.23'

S 40° E - "X" cut on top of a metal culvert, 6" in from East end 35.94'


East Found 3/4" iron, over concrete monument, in monument box 540.60' - S 1/4 Post Section 31

South Steel post and survey marker sign attached 25'

Monument box set by the Jackson County Road Commission.

Signed by Dean R. Gutekunst Date August 1, 1997

Surveyor's Michigan License No. 18658

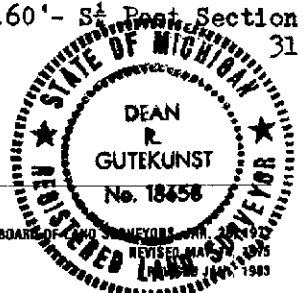

Continued,

A-1

T1S, R2E

A.) - P. A. - 74, recorded by Austin C. Williams, RLS #21275, dated March 12, 1986 in LCRC, Liber 4, Page 43, Jackson County Records.

Found 'T' iron, 1.5' South of center line of Base Line Road, in line with fence South.

6" Box Elder	South	62.15'
4" Willow	S 45 E	43.30'
4" Spruce	S 70 E	104.73'

SURVEY &
REMONUMENTATION

SEP 8 1988

SECTION