

1770  
 1850  
 1880  
 10000

West 1/4 Corner of Section 18, Waterloo Township  
**LAND CORNER RECORDATION CERTIFICATE**  
 Filing Requirement of Act 74, Mich. P.A. 1970

#2064439  
 Liber 1563 Page 905  
 Page 1 of 1  
 Jackson Co., MI  
 Recorded  
 03/12/1998 12:00P  
 Winds Reilly  
 Register of Deeds

For corners in  
**JACKSON**  
 (County)

1. Public Land Survey	T1S R2E	A-6
	T R	
	T R	
	T R	
2. Property Controlling in Section	S T R	
	S T R	
3. Miscellaneous Property in Sec.	S T R	
	S T R	
4. Lot No. _____ Recorded Plat _____		
5. Private Claims _____		

**SURVEY & REMONUMENTATION**  
**SEP 16 1998**  
**SECTION**

Register of Deeds Stamp & File Number

1	A	B	C	D	E	F	G	H	I	J	K	L	M
2		6		5		4		3		2		1	
3													
4		7		8		9		10		11		12	
5													
6		18		17		16		15		14		13	
7													
8		19		20		21		22		23		24	
9													
10		30		29		28		27		26		25	
11													
12		31		32		33		34		35		36	
13													

I, David E. Erickson, in a field survey on October 22, 19 97, do hereby certify that under requirements of P.A. 74, Michigan P.A. of 1970, the corner points mentioned in lines 1 and 2 above were in conformance with regulations and rules therefore as required in the current manual of survey instructions of the United States Department of the Interior, Bureau of Land Management or by a decree of a Court of Law and/or that the corner points mentioned in lines 3, 4 and 5 above were in conformance with the rules of the Michigan Board of Land Surveyors or by a Decree of a Court of Law; established, re-established, monumented, re-monumented, recovered, found as expressed below:

NOTE: Not more than 4 corners, all in the same town and range, may be recorded on this certificate.

A. Description of original monument and accessories and/or subsequent restoration:

This corner not set in the original government survey of 1825.

Old field notes on file at Gutekunst Surveyors (pages 118 and 119) dated August of 1934, are those of Fred Riley. Riley notes the corner as "Drill Hole in Pavement" and records three witnesses: "stone fdn. House SW corner N51°30'E, 71.12 feet"; "Cemt. cor. House NW corner S43°30'E, 75.76 feet" and "Cemt. fdn. House NE corner S46°30'W, 74.10 feet". He also shows distances to the NW and SW corners of Section 18 as being 2659.0 feet.

In 1988, R.L. Enger - LS #28409, recorded the corner as "Established point for corner mid-distance between the NW and SW corners of Section 18 and on the East boundary of T1S-R1E. Corner point is 4.48' North of M-6, T1S-R1E. Set Railroad Spike to monument corner point in centerline of Main Street" and recorded six witnesses: "1-1/2" Pipe at M-6, South 4.48'; Nail and Tag in North side of 36" Spruce, 131°NAZ, 66.1'; Nail and Tag in South side of 30" Pignut, 72°NAZ, 50.4'; Nail and Tag (MDOT) in SE side of Utility Pole, 38°NAZ, 47.1'; Nail and Tag (MDOT) in South side of Utility Pole, 270°NAZ, 22.2'; Nail and Tag in South side of 36" Maple, 312°NAZ, 40.6' " per Land Corner Recordation Certificate (LCRC) recorded in Liber 4, Page 138.


B. Description of corner evidence found and/or method applied in restoring or reestablishing corner:

Did not find railroad spike set by Enger in 1988. Dug down, but did not find drill hole set by Riley in 1934. Recent digging has likely destroyed any evidence. Accepted position as established by Riley in 1934 as the best evidence of the true corner. Rejected position established in 1988 by Enger. Re-established position set by Riley by drilling a hole 3.80 feet North of remonumentation corner M-6, on Town Line. Set a 5/8" rebar with standard Jackson County aluminum cap in hole.

C. Description of monument for corner and accessories established to perpetuate locating the position of the corner:

Set 5/8" diameter x 36" long rebar with Jackson County Remonumentation Corner aluminum cap stamped "LS #29245, 1997, A-6, T1S-R2E".

N 32° E	Set nail and tag #29245, Southeast side power pole	47.47'
S 16° W	Set nail and tag #29245, East side power pole	101.91'
S 88° W	Set nail and tag #29245, North side power pole	21.91'
N 34° W	Set nail and tag #29245, Southwest side 30" Maple	60.57'
South	M-6, T1S-R1E (Jackson County Remonumentation Corner)	3.80'
Northerly	A-5, T1S-R2E (Rebar with cap - remonumentation corner)	2660.49'
Southerly	A-7, T1S-R2E (Harrison Monument)	2658.96'

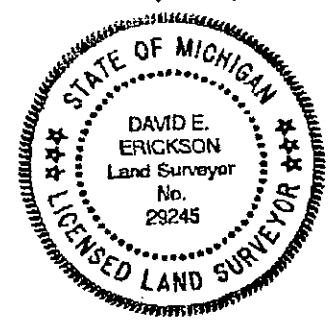

NOTE: Bearings are magnetic

Signed by David E. Erickson Date 3-11-98

Surveyor's Michigan License No. 29245