

**JACKSON COUNTY
APPROVED LAND CORNER
P.A. 345 of 1990**

CENTER SECTION 31
TOMPKINS TOWNSHIP

11-13-96

Chairman Dean C. Hubbard
Date Nov. 13, 1996

**LAND CORNER RECORDATION CERTIFICATE
Filing Requirement of Act 74, Mich. P.A. 1970**

#2023465
Liber 1533 Page 1298
Page 1 of 1
Jackson Co., MI
Recorded
12/26/96 11:11A
Jerry McDevitt
Register of Deeds

For corners in
JACKSON
(County)

Located In: Corner Code #

		1S	2W	B-12
1. Public Land Survey	T	_____	R	_____
	T	_____	R	_____
	T	_____	R	_____
	T	_____	R	_____
2. Property Controlling in Section	S	_____	T	_____
	S	_____	T	_____
3. Miscellaneous Property in Sec.	S	_____	T	_____
	S	_____	T	_____

Register of Deeds Stamp & File Number

4. Lot No. _____, Recorded Plat _____
5. Private Claims _____


	A	B	C	D	E	F	G	H	I	J	K	L	M
2	6	5	4	3	2	1							
3													
4	7	8	9	10	11	12							
5													
6	18	17	16	15	14	13							
7													
8	19	20	21	22	23	24							
9													
10	30	29	28	27	26	25							
11													
12	31	32	33	34	35	36							
13													

I, RONALD L. ENGER, in a field survey on SEPTEMBER 18, 1996, do hereby certify that under requirements of P.A. 74, Michigan P.A. of 1970, the corner points mentioned in lines 1 and 2 above were in conformance with regulations and rules therefore as required in the current manual of survey instructions of the United States Department of the Interior, Bureau of Land Management or by a decree of a Court of Law and/or that the corner points mentioned in lines 3, 4 and 5 above were in conformance with the rules of the Michigan Board of Land Surveyors or by a Decree of a Court of Law; established, re-established, monumented, re-monumented, recovered, found as expressed below:

NOTE: Not more than 4 corners, all in the same town and range, may be recorded on this certificate.

A. Description of original monument and accessories and/or subsequent restoration:

1. NOT SET IN ORIGINAL GOVERNMENT SURVEY.

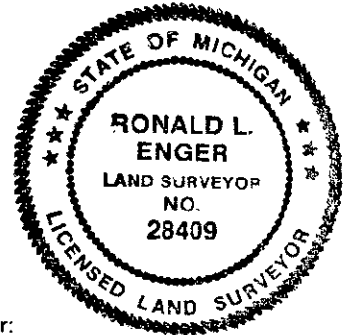

B. Description of corner evidence found and/or method applied in restoring or reestablishing corner:

SEARCHED AT APPARENT LOCATION OF CORNER ON FENCELINE EXTENDED FROM WEST, IN A SWAMP AND FOUND NO EVIDENCE OF CORNER ESTABLISHMENT. TRAVERSED ALL OF SECTION 31 AND SET 1" X 60" ALUMINUM PIPE MONUMENT AT INTERSECTION OF 1/4 LINES. CORNER FALLS IN SWAMP 1 FOOT NORTH OF ANCIENT FENCE LINE FROM WEST IF EXTENDED INTO SWAMP. NORTH-SOUTH FENCE IS NOT WITHIN SEVERAL HUNDRED FEET OF CORNER AND RELATIONSHIP IS NOT KNOWN.

C. Description of monument for corner and accessories established to perpetuate locating the position of the corner:

B-12 T1S R2W
1" X 60" ALUMINUM PIPE MONUMENT WITH ALUMINUM CAP LS 28409
030° NAZ 6" TAMARAC 49.90' NAIL AND TAG IN NW SIDE
180° NAZ 20.50' SURVEY MARKER SIGN POST
240° NAZ 12" TAMARAC 38.46' NAIL AND TAG IN NE SIDE
276° NAZ 13" LOCUST 103.69' NAIL AND TAG IN N. SIDE
281° NAZ 5" HICKORY 93.87' NAIL AND TAG IN SW SIDE
287° NAZ 10" OAK 100.43' NAIL AND TAG IN S. SIDE
NOTE: NAZ IS MAGNETIC AZIMUTH MEASURED FROM NORTH.

Signed by Ronald Enger 28409 Date NOVEMBER 11, 1996
Surveyor's Michigan License No. _____