

8-14

JACKSON COUNTY APPROVED LAND CENTER


P.A. 74 of 1970
Ronald L. Enger
AUG. 14, 1996

NORTH 1/4 CORNER SECTION 17
TOMPKINS TOWNSHIP
LAND CORNER RECORDATION CERTIFICATE
Filing Requirement of Act 74, Mich. P.A. 1970

#2023459
Liber 1533 Page 1
Page 1 of 2
Jackson Co., MI
Recorded
12/26/96 11:09A
Jerry McDevitt
Register of Deeds

For corners in

- JACKSON (County) Located In: Corner Code #
- Public Land Survey T 1S R 2W D-5
 - Property Controlling in Section S T R
 - Miscellaneous Property in Sec. S T R
 - Lot No. , Recorded Plat
 - Private Claims

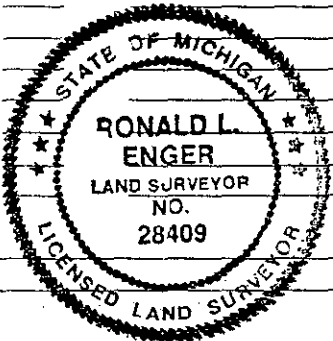

Register of Deeds Stamp & File Number

A	B	C	D	E	F	G	H	I	J	K	L
2	6	5	4	3	2						
3											
4	7	8	9	10	11						
5											
6	18	17	16	15	14						
7											
8	19	20	21	22	23						
9											
10	30	29	28	27	26						
11											
12	31	32	33	34	35						
13											

I, RONALD L. ENGER, in a field survey on MAY 3, 1996, do hereby certify that under requirements of P.A. 74, Michigan P.A. of 1970, the corner points mentioned in lines 1 and 2 above were in conformance with regulations and rules therefore as required in the current manual of survey instructions of the United States Department of the Interior, Bureau of Land Management or by a decree of a Court of Law and/or that the corner points mentioned in lines 3, 4 and 5 above were in conformance with the rules of the Michigan Board of Land Surveyors or by a Decree of a Court of Law; established, re-established, monumented, re-monumented, recovered, found as expressed below:

NOTE: Not more than 4 corners, all in the same town and range, may be recorded on this certificate.

A. Description of original monument and accessories and/or subsequent restoration:

- POST SET IN ORIGINAL GOVERNMENT SURVEY BY LUCIUS LYON, D.S. BETWEEN FEB. 2 AND FEB. 12, 1825 AND TWO WITNESSES RECORDED:
W.O. 26 N53-1/2E 277 (182.8')
DO. 30 S88W 127 (83.8')

CONTINUED ON BACK

B. Description of corner evidence found and/or method applied in restoring or reestablishing corner:

FOUND FIRE CLAY AND 3/4" PIPE WITH CAP #7863 ON EAST SIDE. NO SIGN OF GLO WITNESSES. HOLCROFT'S SECOND WITNESS (B. OAK 8" N65W 54 1/3 (35.91') IS NOW A 30" STUMP AND MEASURES 36.2' FROM CENTER TO FIRE CLAY. ACCEPTED FIRE CLAY AS CORNER AS PERPETUATED BY HOLCROFT. SET STANDARD MONUMENT IN IT'S PLACE AND BURIED FIRE CLAY ON NORTH SIDE.

C. Description of monument for corner and accessories established to perpetuate locating the position of the corner:

- D-5 T1S R2W
4 INCH DIAMETER BY 36" LONG CONCRETE MONUMENT WITH ALUMINUM CAP LS 28409
- | | | | |
|----------|-------------|--------|-------------------------------------|
| 077° NAZ | 14" CHERRY | 30.28' | NAIL AND TAG LS 28409 IN NORTH SIDE |
| 195° NAZ | 8" BASSWOOD | 15.06' | NAIL AND TAG LS 28409 IN EAST SIDE |
| 306° NAZ | 14" OAK | 37.90' | NAIL AND TAG LS 28409 IN SOUTH SIDE |
| 353° NAZ | 8" BASSWOOD | 33.75' | NAIL AND TAG LS 28409 IN EAST SIDE |
- NOTE: NAZ IS MAGNETIC AZIMUTH MEASURED FROM NORTH.

Signed by Ronald L. Enger Date MAY 3, 1996
Surveyor's Michigan License No. 28409

D-5 T1S R2W
PART A CONTINUED

2. ON MAY 21, 1886 JOHN HOLCROFT REPORTED "CORNER GONE, FOUND GOOD REMAINS OF FIRST WITNESS AND STUMP OF SECOND WITNESS (POST IS ON THE NORTH SIDE OF A LARGE ROUND GATE POST.)" HE SET FIRE CLAY POST AND THEN RECORDED TWO WITNESSES:

B.O. 11 N2W 31-1/2 (20.8')

DO. 8 N65W 54-1/3 (35.9')