

**JACKSON COUNTY
APPROVED LAND CORNER
P.A. 336 of 1937**

NORTH 1/4 CORNER SECTION 29
TOMPKINS TOWNSHIP

9-11-96

Chairman Neal Lubbert
Date Sept. 11, 1996


**LAND CORNER RECORDATION CERTIFICATE
Filing Requirement of Act 74, Mich. P.A. 1970**

#2023466
Liber 1533 Page 1299
Page 1 of 1
Jackson Co., MI
Recorded
12/26/96 11:11A
Jerry McDevitt
Register of Deeds

For corners in
JACKSON
(County)

Located in: Corner Code --#

- | | | | | | |
|---------------------------------------|---|-----------|---|-----------|-----|
| 1. Public Land Survey | T | <u>1S</u> | R | <u>2W</u> | D-9 |
| | T | | R | | |
| | T | | R | | |
| | T | | R | | |
| 2. Property Controlling in Section | S | | T | | R |
| | S | | T | | R |
| 3. Miscellaneous Property in Sec. | S | | T | | R |
| | S | | T | | R |
| 4. Lot No. _____, Recorded Plat _____ | | | | | |
| 5. Private Claims _____ | | | | | |

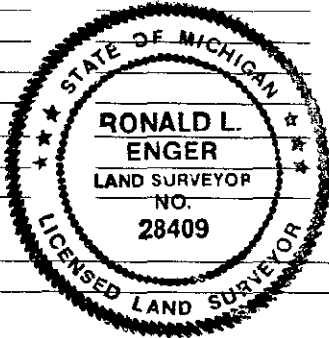

Register of Deeds Stamp & File Number

	A	B	C	D	E	F	G	H	I	J	K	L	M
2	6	5	4	3	2								
3													
4	7	8	9	10	11	12							
5													
6	18	17	16	15	14	13							
7													
8	19	20	21	22	23	24							
9													
10	30	29	28	27	26	25							
11													
12	31	32	33	34	35	36							
13													

I, RONALD L. ENGER, in a field survey on APRIL 25, 1996

do hereby certify that under requirements of P.A. 74, Michigan P.A. of 1970, the corner points mentioned in lines 1 and 2 above were in conformance with regulations and rules therefore as required in the current manual of survey instructions of the United States Department of the Interior, Bureau of Land Management or by a decree of a Court of Law and/or that the corner points mentioned in lines 3, 4 and 5 above were in conformance with the rules of the Michigan Board of Land Surveyors or by a Decree of a Court of Law; established, re-established, monumented, re-monumented, recovered, found as expressed below:

NOTE: Not more than 4 corners, all in the same town and range, may be recorded on this certificate.

A. Description of original monument and accessories and/or subsequent restoration:

- POST SET IN ORIGINAL GOVERNMENT SURVEY BY LUCUIS LYON, D.S. BETWEEN FEB 2 AND FEB 12, 1825 AND TWO WITNESSES RECORDED:
 B.O. 19 N53W 43 (28.4')
 W.O. 28 S66-1/2W 47 (31.0')
- ON MAY 24, 1886 JOHN HOLCROFT REPORTED "CORNER GONE; FOUND BOTH WITNESSES, STUMPS. FIRST LEVEL WITH SURFACE AND THE SECOND ABOVE GROUND."
 Y. OAK 5 S37W 75-3/4 (50.0')
 HICKORY 10 S19-1/4E 83-1/4 (54.9')

B. Description of corner evidence found and/or method applied in restoring or reestablishing corner:

SEARCHED AT APPARENT LOCATION OF CORNER AND FOUND 3/4" PINCHPIPE IN MONUMENT BOX 6' EAST OF CENTER LINE OF FISK ROAD ON CENTER LINE OF GORDON ROAD. REMOVED PIPE AND EXCAVATED THROUGH BOTTOM OF MONUMENT BOX AND FOUND SECOND 3/4" PIPE NEXT TO THE FIRST ONE. FOUND FIRE CLAY BELOW SECOND PIPE. 2.5' DEEP. ACCEPTED FIRE CLAY AS CORNER AS PERPETUATED BY HOLCROFT AND SET 4" X 24" CONCRETE MONUMENT (36" MONUMENT WITH BOTTOM 12" BROKEN OFF) AND ALUMINUM CAP DIRECTLY OVER THE FIRE CLAY.

C. Description of monument for corner and accessories established to perpetuate locating the position of the corner:

- D-9 T1S R2W
 4" X 24" CONCRETE MONUMENT AND JACKSON CO. REMONUMENTATION ALUMINUM CAP STAMPED LS 28409 IN MONUMENT BOX.
- | | | | |
|----------|------------|---------|-------------------------|
| 75° NAZ | 40" B. OAK | 88.70' | NAIL AND TAG SOUTH SIDE |
| 167° NAZ | 36" OAK | 70.30' | CENTERLINE WEST SIDE |
| 174° NAZ | 28" OAK | 103.90' | NAIL AND TAG EAST SIDE |
| 197° NAZ | 28" CHERRY | 131.85' | NAIL AND TAG EAST SIDE |
| 265° NAZ | 36" OAK | 181.40' | NAIL AND TAG NORTH SIDE |
| 315° NAZ | | 46.00' | SURVEY MARKER SIGN POST |

NOTE: NAZ IS MAGNETIC AZIMUTH MEASURED FROM NORTH.

Signed by Neal Enger Date SEPTEMBER 6, 1996

Surveyor's Michigan License No. 28409