

7  
2-13-95

**JACKSON COUNTY  
APPROVED LAND CORNER  
P.A. 345 of 1996**

Chairman Dean K. Gutterman  
Date Dec. 13, 1995

SOUTHEAST CORNER SECTION 8  
TOMPKINS TOWNSHIP  
**LAND CORNER RECORDATION CERTIFICATE**  
Filing Requirement of Act 74, Mich. P.A. 1970

LIBER **1501** PAGE **1093**

For corners in

JACKSON Located In: \_\_\_\_\_ Corner Code #  
(County)


1. Public Land Survey T 1S R 2W E-5  
T \_\_\_\_\_ R \_\_\_\_\_  
T \_\_\_\_\_ R \_\_\_\_\_  
T \_\_\_\_\_ R \_\_\_\_\_

2. Property Controlling S \_\_\_\_\_ T \_\_\_\_\_ R \_\_\_\_\_  
in Section S \_\_\_\_\_ T \_\_\_\_\_ R \_\_\_\_\_

3. Miscellaneous S \_\_\_\_\_ T \_\_\_\_\_ R \_\_\_\_\_  
Property in Sec. S \_\_\_\_\_ T \_\_\_\_\_ R \_\_\_\_\_

4. Lot No. \_\_\_\_\_, Recorded Plat \_\_\_\_\_

5. Private Claims \_\_\_\_\_

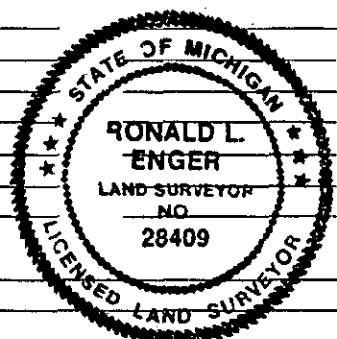

STATE OF MICHIGAN  
JACKSON COUNTY  
RECORDED  
29 DEC 95 10:28 A.M.  
GERALD J. McDEVITT  
REGISTER OF DEEDS  
Register of Deeds Stamp & File Number

A	B	C	D	E	F	G	H	I	J	K	L	M
2	6	5	4	3	2	1						
3												
4	7	8	9	10	11	12						
5												
6	18	17	16	15	14	13						
7												
8	19	20	21	22	23	24						
9												
10	30	29	28	27	26	25						
11												
12	31	32	33	34	35	36						
13												

I, RONALD L. ENGER, in a field survey on DECEMBER 7, 19 95, do hereby certify that under requirements of P.A. 74, Michigan P.A. of 1970, the corner points mentioned in lines 1 and 2 above were in conformance with regulations and rules therefore as required in the current manual of survey instructions of the United States Department of the Interior, Bureau of Land Management or by a decree of a Court of Law and/or that the corner points mentioned in lines 3, 4 and 5 above were in conformance with the rules of the Michigan Board of Land Surveyors or by a Decree of a Court of Law; established, re-established, monumented, re-monumented, recovered, found as expressed below:

**NOTE: Not more than 4 corners, all in the same town and range, may be recorded on this certificate.**

**A. Description of original monument and accessories and/or subsequent restoration:**

1. POST SET IN ORIGINAL GOVERNMENT SURVEY BY LUCIUS LYON, D.S. BETWEEN FEB. 2 AND FEB. 12, 1825 AND TWO WITNESSES RECORDED:  
W.O. 16 S49W 18 (11.9')  
D.O. 14 S78E 25 (16.5')

REMONUMENTATION

FEB 22 1996

COMMISSION

CONTINUED ON BACK

**B. Description of corner evidence found and/or method applied in restoring or reestablishing corner:**

SEARCHED AT APPARENT LOCATION OF CORNER AND FOUND 5" X 36" WELL CASING WITH FIRECLAY INSIDE OF IT. FOUND 1/2" BAR AND CAP RLS 7863/RLS 18658 ALSO INSIDE THE CASING ON NORTH SIDE OF THE FIRECLAY. ACCEPTED THE FIRECLAY AS HOLCROFT'S PERPETUATION OF THE ORIGINAL CORNER POSITION. REMOVED THE WELL CASING WITH FIRECLAY AND BAR STILL INSIDE IT. COULD NOT RETRIEVE FIRECLAY FROM WELL CASING SINCE CASING WAS PACKED TIGHT WITH WET CLAY. SET STANDARD MONUMENT FOR PA 345 REMONUMENTATION IN JACKSON COUNTY IN POSITION OF THE FIRECLAY. PLACED WELL CASING WITH FIRECLAY AND THE BAR ON EAST SIDE OF MONUMENT.

\$ 2.00 REMONUMENTATION  
\$ 9.00 CORNER REMONUMENTATION

**C. Description of monument for corner and accessories established to perpetuate locating the position of the corner:**

E-5 T1S R2W  
4 INCH DIAMETER BY 36" LONG CONCRETE MONUMENT WITH ALUMINUM CAP LS 28409  
000° NAZ 10" HICKORY (DLB) 43.55' NAIL IN EAST SIDE  
083° NAZ 18" POPLAR (DLB) 29.45' NAIL IN NORTH SIDE  
140° NAZ 8" HICKORY 25.07' NAIL AND TAG PS 28409 EAST SIDE  
161° NAZ 14" ASH (DLB) 19.10' NAIL IN EAST SIDE  
295° NAZ 12" OAK (DLB) 24.80' NAIL IN NORTH SIDE

NOTE: NAZ IS MAGNETIC AZIMUTH MEASURED FROM NORTH.

Signed by Ronald L. Enger

Date DECEMBER 12, 1995

Surveyor's Michigan License No. 28409

E-5 T1S R2W  
PART A CONTINUED

2. ON DECEMBER 4, 1885 JOHN HOLCROFT REPORTED "FOUND STONE AT CORNER AND REMAINS OF OLD STAKE BELOW IT. ALSO REMAINS OF 1ST WITNESS. FENCES AGREEING (CORNER HAD BEEN KEPT UP)" AND RECORDED TWO WITNESSES:

HICKORY 7 N47-1/4 W 58 (38.28')  
DO. 8 S18-1/4 E 43-1/4 (28.54')

3. DONALD L. BISSELL, PS #18655, RECORDED CORNER IN LIBER 4 OF CORNERS, PAGE 175, IN DECEMBER 1989 (FIELD SURVEY IN MARCH 1989) AS A FOUND FIRECLAY CYLINDER. BISSELL SAYS HE PLACED A 5" BY 30" WELL CASING OVER THE FIRECLAY CYLINDER.

S22°E 19.11' 14" W. ASH  
N63°W 24.75' 12" OAK  
N04°E 43.54' 10" HICKORY  
N86°E 29.47' 16" POPLAR