

JACKSON COUNTY
 APPROVED LAND CORNER
 P.A. 335 of 1970

EAST 1/4 CORNER SECTION 20
 TOMPKINS TOWNSHIP

9-11-96

Chairman Deal Subbana
 Date Sept. 11, 1996

LAND CORNER RECORDATION CERTIFICATE
 Filing Requirement of Act 74, Mich. P.A. 1970

For corners in
JACKSON
 (County)

	Located In:	Corner Code #
1. Public Land Survey	T <u>1S</u> R <u>2W</u>	<u>E-8</u>
	T _____ R _____	_____
	T _____ R _____	_____
	T _____ R _____	_____
2. Property Controlling in Section	S _____ T _____ R _____	_____
	S _____ T _____ R _____	_____
3. Miscellaneous Property in Sec.	S _____ T _____ R _____	_____
	S _____ T _____ R _____	_____

#2023454
 Liber 1533 Page 1:
 Page 1 of 2
 Jackson Co., MI
 Recorded
 12/26/96 11:07A
 Jerry McDevitt
 Register of Deeds

Register of Deeds Stamp & File Number

4. Lot No. _____, Recorded Plat _____
 5. Private Claims _____


I, RONALD L. ENGER, in a field survey on MAY 3, 1996, do hereby certify that under requirements of P.A. 74, Michigan P.A. of 1970, the corner points mentioned in lines 1 and 2 above were in conformance with regulations and rules therefore as required in the current manual of survey instructions of the United States Department of the Interior, Bureau of Land Management or by a decree of a Court of Law and/or that the corner points mentioned in lines 3, 4 and 5 above were in conformance with the rules of the Michigan Board of Land Surveyors or by a Decree of a Court of Law; established, re-established, monumented, re-monumented, recovered, found as expressed below:

A	B	C	D	E	F	G	H	I	J	K	L
2	6	5	4	3	2	1					
3											
4	7	8	9	10	11	12					
5											
6	18	17	16	15	14	13					
7											
8	19	20	21	22	23	24					
9											
10	30	29	28	27	26	25					
11											
12	31	32	33	34	35	36					
13											

NOTE: Not more than 4 corners, all in the same town and range, may be recorded on this certificate.

A. Description of original monument and accessories and/or subsequent restoration:

1. POST SET IN ORIGINAL GOVERNMENT SURVEY BY LUCIUS LYON, D.S. BETWEEN FEB. 2 AND FEB. 12, 1825 AND TWO WITNESSES RECORDED:
 B.O. 17 S75E 80 (52.8')
 D.O. 16 S66W 40 (26.4')

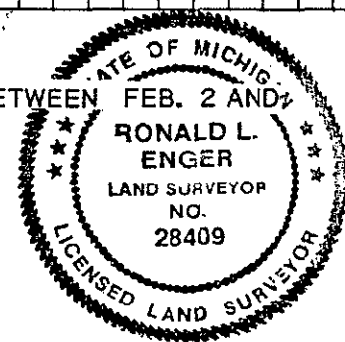

CONTINUED ON BACK

B. Description of corner evidence found and/or method applied in restoring or reestablishing corner:

SEARCHED AT APPARENT LOCATION OF CORNER AND FOUND FIRE CLAY WITH 3/4" PIPE AND ILLEGIBLE CAP ON EAST SIDE 7' NORTH OF R.R. TIE ANCHOR POST. NO GLO OR HOLCROFT WITNESSES IN EXISTENCE. ALL OF GUTEKUNST'S AND YOUNG'S WITNESSES ARE NOW STUMPS. ACCEPTED FIRE CLAY AS CORNER AS PERPETUATED BY HOLCROFT AND REPLACED WITH STANDARD MONUMENT. LEFT PIPE IN PLACE AND PLACED FIRE CLAY ON SOUTH SIDE.

C. Description of monument for corner and accessories established to perpetuate locating the position of the corner:

E-8 T1S R2W
 4 INCH DIAMETER BY 36" LONG CONCRETE MONUMENT WITH ALUMINUM CAP LS 28409
 040° NAZ 7" HICKORY 22.70' NAIL AND TAG LS 28409 IN EAST SIDE
 173° NAZ 23" CHERRY 31.61' NAIL AND TAG LS 28409 IN WEST SIDE
 184° NAZ R.R. TIE F.P. 06.96' NAIL AND TAG LS 28409 IN EAST SIDE
 245° NAZ 6" HICKORY 16.40' NAIL AND TAG LS 28409 IN NW SIDE
 286° NAZ 6" MAPLE 36.69' NAIL AND TAG LS 28409 IN SOUTH SIDE
 180° NAZ 2.0' SURVEY MARKER SIGN POST

NOTE: NAZ IS MAGNETIC AZIMUTH MEASURED FROM NORTH.

Signed by Ronald L. Enger Date MAY 3, 1996
 Surveyor's Michigan License No. 28409

E-8 T1S R2W
PART A CONTINUED.

2. ON MAY 29, 1886 JOHN HOLCROFT REPORTED "FOUND STAKE AT CORNER AND SLIGHT REMAINS OF FIRST WITNESS AND GOOD REMAINS OF SECOND WITNESS." HE ALSO RECORDED TWO WITNESSES:

B. OAK	18	S19-1/4 E	29-2/3 (19.6')
W. OAK	7	N62-3/4 E	32-1/2 (21.5')

3. DEAN GUTEKUNST, RLS 18658 WITNESSED CORNER ON MAY 20, 1974 FOUND FIRE CLAY, SET 3/4" X 30" IRON ON NORTH SIDE.

6 1/2' N. OF COR. POST OF FENCES E,W & S, STONE ROW NORTH.

N 5° W	4" OAK	37.48'
N 60° E	5" HICK	31.97'
N 60° E	30" OAK	6.98'
S 45° E	8" OAK	29.79'
S 20° W	6" OAK	32.61'
S 60° W	2" HICK	15.3'

4. GEORGE M. YOUNG, LS #17640, RECORDED CORNER IN LIBER 3 OF CORNERS, PAGE 114, IN OCTOBER 1977 (FIELD SURVEY IN JULY 1977) AS A FOUND 3" FIRECLAY WITH 3/4" PIPE BESIDE IT.

N50°E	7.00'	36" OAK
S45°E	29.80'	12" OAK
SOUTH	17.95'	18" CHERRY
3" FIRE CLAY WITH 3/4" PIPE		