

**JACKSON COUNTY
APPROVED LAND CORNER**

P.A. 345 of 1970

Chairman Dean R. Luthe

Date Dec. 26, 1996

**CENTER SECTION 33
TOMPKINS TOWNSHIP**

**LAND CORNER RECORDATION CERTIFICATE
Filing Requirement of Act 74, Mich. P.A. 1970**

#2023679
Liber 1534 Page 199
Page 1 of 1
Jackson Co., MI
Recorded
12/27/96 12:06P
Jerry McDavitt
Register of Deeds

For corners in
JACKSON

(County)

Located In:

Corner Code #

		1S	2W	F-12
1. Public Land Survey	T	_____	R	_____
	T	_____	R	_____
	T	_____	R	_____
	T	_____	R	_____
2. Property Controlling in Section	S	_____	T	_____
	S	_____	T	_____
3. Miscellaneous Property in Sec.	S	_____	T	_____
	S	_____	T	_____

Register of Deeds Stamp & File Number

4. Lot No. _____, Recorded Plat _____
5. Private Claims _____

	A	B	C	D	E	F	G	H	I	J	K	L	M
2	6	5	4	3	2	1							
3													
4	7	8	9	10	11	12							
5													
6	18	17	16	15	14	13							
7													
8	19	20	21	22	23	24							
9													
10	30	29	28	27	26	25							
11													
12	31	32	33	34	35	36							
13													


RONALD L. ENGER DECEMBER 20 1996

I, RONALD L. ENGER, in a field survey on DECEMBER 20, 1996, do hereby certify that under requirements of P.A. 74, Michigan P.A. of 1970, the corner points mentioned in lines 1 and 2 above were in conformance with regulations and rules therefore as required in the current manual of survey instructions of the United States Department of the Interior, Bureau of Land Management or by a decree of a Court of Law and/or that the corner points mentioned in lines 3, 4 and 5 above were in conformance with the rules of the Michigan Board of Land Surveyors or by a Decree of a Court of Law; established, re-established, monumented, re-monumented, recovered, found as expressed below:

NOTE: Not more than 4 corners, all in the same town and range, may be recorded on this certificate.

A. Description of original monument and accessories and/or subsequent restoration:

1. POST NOT SET IN ORIGINAL GOVERNMENT SURVEY

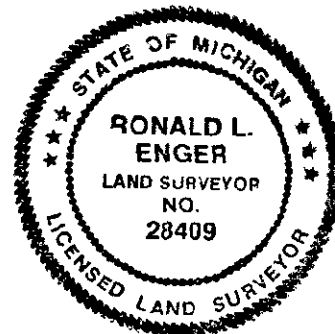

B. Description of corner evidence found and/or method applied in restoring or reestablishing corner:

SEARCHED AT APPARENT LOCATION OF CORNER AND FOUND A SPIKE & RIBBON IN WEST SIDE 36" OAK THAT APPEARED TO BE A WITNESS TO CORNER BUT COULD NOT FIND ANY EVIDENCE OF MONUMENT OR ANY OTHER WITNESSES. TRAVERSED SECTION 33 AND SET STANDARD MONUMENT AT INTERSECTION OF 1/4 LINES. MONUMENT FALLS 2' NORTH OF FENCE TO EAST & 1' WEST OF FENCE TO NORTH.

C. Description of monument for corner and accessories established to perpetuate locating the position of the corner:

F-12 T1S R2W
4 INCH DIAMETER BY 36" LONG CONCRETE MONUMENT WITH ALUMINUM CAP STAMPED LS 28409
006° NAZ 36" OAK 15.69' NAIL & TAG IN WEST SIDE
097° NAZ 19" OAK 7.80' NAIL & TAG IN SOUTH SIDE
185° NAZ 2.00' SURVEY MARKER SIGN POST
187° NAZ 6" CHERRY 16.77' NAIL & TAG IN EAST SIDE
269° NAZ 5" OAK 40.18' NAIL & TAG IN NORTH SIDE

NOTE: NAIL & TAGS ARE 20D SPIKES AND ALUMINUM TAGS STAMPED PS 28409
NOTE: NAZ IS MAGNETIC AZIMUTH MEASURED FROM NORTH.

Signed by Ronald L. Enger Date DECEMBER 21, 1996
Surveyor's Michigan License No. 28409