

2

12-13-95


JACKSON COUNTY APPROVED LAND CORNER P.A. 345 of 1990

Chairman [Signature] Date Dec 13, 1995

SOUTH 1/4 CORNER SECTION 33 TOMPKINS TOWNSHIP LAND CORNER RECORDATION CERTIFICATE Filing Requirement of Act 74, Mich. P.A. 1970

LIBER 1501 PAGE 1076

Form with fields for County (JACKSON), Located In, Corner Code (F-13), and survey types (Public Land Survey, Property Controlling, etc.)

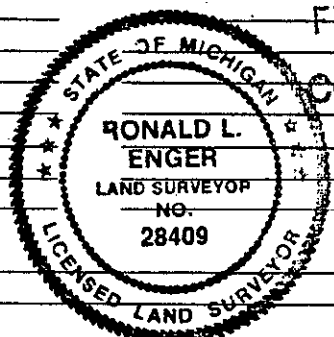

REMONUMENTATION FEB 22 1996 COMMISSION

STATE OF MICHIGAN JACKSON COUNTY RECORDED 29 DEC 95 10:27 A.M. GERALD J. McDEVITT REGISTER OF DEEDS

Grid table with columns A-M and rows 1-13, containing numbers 1-36 and a dot at row 12, column G.

I, RONALD L. ENGER, in a field survey on DECEMBER 6, 1995, do hereby certify that under requirements of P.A. 74, Michigan P.A. of 1970, the corner points mentioned in lines 1 and 2 above were in conformance with regulations and rules therefore as required in the current manual of survey instructions of the United States Department of the Interior, Bureau of Land Management or by a decree of a Court of Law and/or that the corner points mentioned in lines 3, 4 and 5 above were in conformance with the rules of the Michigan Board of Land Surveyors or by a Decree of a Court of Law; established, re-established, monumented, re-monumented, recovered, found as expressed below:

NOTE: Not more than 4 corners, all in the same town and range, may be recorded on this certificate.

A. Description of original monument and accessories and/or subsequent restoration:

- 1. POST SET BY JOSEPH WAMPLER, D.S. IN JANUARY, 1824 AND RECORDED TWO WITNESSES: ASH 14 N24E 5 (3.30') DO. 7 N68W 56 (36.96')
2. ON MAY 29, 1886 JOHN HOLCROFT REPORTED THAT CORNER FALLS "IN MINORS MILL POND". HE DID NOT LIST ANY WITNESSES AND PRESUMABLY DID NOT SET A FIRECLAY.

B. Description of corner evidence found and/or method applied in restoring or reestablishing corner:

TRAVERSED ALONG THE SOUTH TOWNSHIP LINE AND LOCATED THE SECTION CORNERS EAST (G-13, FIRECLAY) AND WEST (E-13, FIRECLAY) OF F-13. MEASURED DISTANCE BETWEEN E-13 AND G-13 WAS 5295.77 FEET. COMPUTED POSITION HALF WAY AND ON LINE BETWEEN THE TWO CORNERS. THOUGHT COMPUTED CORNER POSITION WAS LOCATED IN STANDING WATER OF MILL POND. SET 1" X 60" ALUMINUM PIPE MONUMENT FOR PA 345 REMONUMENTATION IN JACKSON COUNTY AS WITNESS CORNER 339.67 FEET EAST OF THE COMPUTED CORNER POSITION ON THE TOWNSHIP LINE. UPON SETTING MONUMENT IT WAS REALIZED THAT THE ACTUAL CORNER COULD PROBABLY BE SET FROM OTHER SIDE OF MILL POND. EXTENDED EXISTING TRAVERSE AND ATTEMPTED TO FIND CORNER. POSITION FALLS IN VAST SWAMP

CONTINUED ON BACK \$ 2.00 REMONUMENTATION \$ 9.00 CORNER REMONUMENTATION

C. Description of monument for corner and accessories established to perpetuate locating the position of the corner:

F-13 T1S R2W 1" X 60" JACKSON COUNTY ALUMINUM PIPE MONUMENT WITH ALUMINUM CAP STAMPED "28409" 268° NAZ 24" OAK 549.41' NAIL AND TAG PS 28409 IN NORTH SIDE 271° NAZ 18" OAK 521.84' NAIL AND TAG PS 28409 IN NORTH SIDE 272° NAZ 24" OAK 506.47' NAIL AND TAG PS 28409 IN NE SIDE 274° NAZ 14" OAK 499.09' NAIL AND TAG PS 28409 IN NORTH SIDE 278° NAZ 8" OAK 474.44' NAIL AND TAG PS 28409 IN SE SIDE

CONTINUED ON BACK

Signed by [Signature] Date DECEMBER 6, 1995 Surveyor's Michigan License No. 28409

F-13 T1S R2W
PART B CONTINUED

SURROUNDING MILLPOND WITH 1' TO 2' OF STANDING WATER. SEARCHED AT COMPUTED LOCATION AND FOUND NOTHING. FOUND NO EVIDENCE OF MARKER OR WITNESSES FROM THE ORIGINAL GOVERNMENT SURVEY. THERE IS NO OCCUPATION NORTH, SOUTH, EAST OR WEST ANYWHERE NEAR THE GENERAL LOCATION OF THE CORNER. DETERMINED CORNER TO BE LOST, PROBABLY DUE TO THE MILLPOND. ESTABLISHED CORNER HALF WAY AND ON LINE BETWEEN E-13 AND G-13, BOTH OF WHICH ARE FIRECLAYS. SET 1" X 60" ALUMINUM PIPE MONUMENT FOR PA 345 REMONUMENTATION IN JACKSON COUNTY AT CORNER LOCATION. LEFT MONUMENT WHICH HAD BEEN SET AS A WITNESS CORNER AS A WITNESS TO F-13. MEASURED EAST 2647.89' TO G-13 AND WEST 2647.89 FEET TO E-13.

PART C CONTINUED

90°00'02"	NAZ 2647.89'	4" X 36" CONCRETE MONUMENT WITH ALUMINUM CAP LS 28409 AT G-13
90°00'02"	NAZ 339.67'	1" X 60" ALUMINUM PIPE MONUMENT WITH JACKSON COUNTY PA 345 CAP LS 28409
270°00'02"	NAZ 2647.89'	1" X 36" ALUMINUM PIPE MONUMENT WITH JACKSON COUNTY PA 345 CAP LS 28409 AT E-13

NOTE: NAZ IS NORTH AZIMUTH. FOR THIS CERTIFICATE, 270°00'00" WAS ASSUMED AS DIRECTION OF THE TOWNSHIP LINE BETWEEN G-13 AND E-13.