

**JACKSON COUNTY
APPROVED LAND CORNER
P.A. 345 of 1990**

W $\frac{1}{2}$ CORNER SECTION 11
TOMPKINS TOWNSHIP

Chairman *Dan R. [Signature]*
Date MAY 15, 1997

**LAND CORNER RECORDATION CERTIFICATE
Filing Requirement of Act 74, Mich. P.A. 1970**

#2037792
Liber 1544 Page 361
Page 1 of 2
Jackson Co., MI
Recorded
06/11/97 10:59A
Mindy Reilly
Register of Deeds

For corners in

<u>JACKSON</u> (County)	Located In:	Corner Code #
1. Public Land Survey	T1S R 2W	1-4
	T R	
	T R	
	T R	
2. Property Controlling in Section	S T R	
	S T R	
3. Miscellaneous Property in Sec.	S T R	
	S T R	

**SURVEY &
REMONUMENTATION**

APR 07 1998

SECTION

Register of Deeds Stamp & File Number

4. Lot No. _____, Recorded Plat _____
5. Private Claims _____

DAVID CLIFFORD, in a field survey on APR 22, 1997, do hereby state that under requirements of P.A. 74, Michigan P.A. of 1970, the corner points mentioned in lines 1 and 2 above were in conformance with regulations and rules therefore as required in the current manual of survey instructions of the United States Department of the Interior, Bureau of Land Management or by a decree of a Court of Law and/or that the corner points mentioned in lines 3, 4 and 5 above were in conformance with the rules of the Michigan Board of Land Surveyors or by a Decree of a Court of Law; established, re-established, monumented, recovered, found as expressed below:

NOTE: Not more than 2 corners, all in the same town and range, may be recorded on this certificate.


	A	B	C	D	E	F	G	H	I	J	K	L	M
1													
2	6		5		4		3		2		1		
3													
4	7		8		9		10		11		12		
5													
6	18		17		16		15		14		13		
7													
8	19		20		21		22		23		24		
9													
10	30		29		28		27		26		25		
11													
12	31		32		33		34		35		36		
13													

A. Description of original monument and accessories and/or subsequent restoration:

- POST SET IN ORIGINAL GOVERNMENT SURVEY BY LUCIUS LYON, D.S. IN FEBRUARY, 1825 AND TWO WITNESSES RECORDED:
RED OAK 34 S44 $\frac{1}{2}$ E 46 (30.4')
IRONWOOD 8 N31W 19 (12.5')
- IN NOVEMBER 1885 JOHN HOLCROFT FOUND STAKE AT CORNER AND REMAINS OF BOTH WITNESSES. HE SET A FIRE CLAY AND RECORDED 2 WITNESSES:
W. OAK 10 S2E 30 $\frac{1}{2}$ (20.0')
HICKORY 9 EAST 152 $\frac{1}{2}$ (100.5')
CONTINUED ON BACK

B. Description of corner evidence found and/or method applied in restoring or reestablishing corner:

SEARCHED AT APPARENT LOCATION OF CORNER AND FOUND 1 $\frac{1}{2}$ " PIPE IN MOUND OF STONE AT EAST-SOUTH FENCE LINE. BOTH OF HOLCROFT'S WITNESSES STILL STAND. REMOVED PIPE AND EXCAVATED THROUGH PILE OF STONE AND FOUND FIRE CLAY IN GOOD CONDITION WITH 3/4" PIPE & CAP #7863 ON EAST SIDE & 1/2" BAR ON WEST SIDE. ACCEPTED FIRE CLAY AS CORNER AS PERPETUATED BY HOLCROFT AND SET STANDARD CONCRETE MONUMENT ABOVE IT.

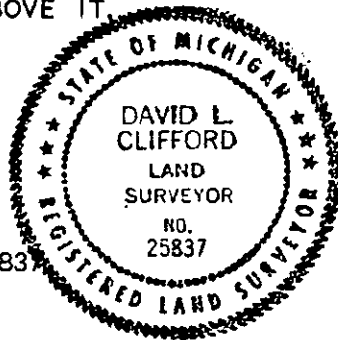

C. Description of monument for corner and accessories established to perpetuate locating the position of the corner:

- 1-4 T1S R2W
- | | |
|--|--------------------------------------|
| 4 INCH DIAMETER BY 36" LONG CONCRETE MONUMENT AND CAP STAMPED LS 25837 | |
| 071° NAZ 24" ASH 20.30' | 40D SPIKE IN NORTH SIDE |
| 082° NAZ 9" HICKORY 22.35' | 40D SPIKE IN SOUTH SIDE |
| 094° NAZ 24" HICKORY 100.60' | NAIL & TAG #28409 IN NORTH SIDE |
| 094° NAZ 36" ASH 28.75' | NAIL & TAG #28409 IN NORTH SIDE |
| 183° NAZ 36" OAK 22.06' | NAIL & TAG #28409 IN EAST SIDE |
| 262° NAZ 4" OAK 17.0' | SURVEY MARKER SIGN POST ON EAST SIDE |
| 274° NAZ 6" HICKORY 34.85' | NAIL & TAG #28409 IN NORTH SIDE |

NOTE: NAZ IS MAGNETIC AZIMUTH MEASURED FROM NORTH.

Signed by *Dave Clifford*
Surveyor's Michigan License No. 25837

Date MAY 01, 1997