

z:dxz y@xz

JACKSON COUNTY  
APPROVED LAND CORNER  
P.A. 345 of 1950

Chairman Dean R. Lott

Date AUG. 13, 1997

NORTHEAST 1/4 CORNER SECTION 15  
TOMPKINS TOWNSHIP  
LAND CORNER RECORDATION CERTIFICATE  
Filing Requirement of Act 74, Mich. P.A. 1970

For corners in

JACKSON	Located In:	Corner Code #
(County)		
1. Public Land Survey	T 1S R 2W	1-5
	T R	
	T R	
	T R	
2. Property Controlling in Section	S T R	
	S T R	
3. Miscellaneous Property in Sec.	S T R	
	S T R	

SURVEY &  
REMONUMENTATION

APR 07 1998

SECTION

#2057139  
Liber 1558 Page 534  
Page 1 of 1  
Jackson Co., MI  
Recorded  
12/29/1997 10:26A  
Mindy Reilly  
Register of Deeds

Register of Deeds Stamp & File Number

4. Lot No. \_\_\_\_\_, Recorded Plat \_\_\_\_\_  
5. Private Claims \_\_\_\_\_

A	B	C	D	E	F	G	H	I	J	K	L	M
1												
2	6	5	4	3	2	1						
3												
4	7	8	9	10	11	12						
5												
6	18	17	16	15	14	13						
7												
8	19	20	21	22	23	24						
9												
10	30	29	28	27	26	25						
11												
12	31	32	33	34	35	36						
13												

I, DAVID L. CLIFFORD, in a field survey on MAY. 12, 1997 do hereby state that under requirements of P.A. 74, Michigan P.A. of 1970, the corner points mentioned in lines 1 and 2 above were in conformance with regulations and rules therefore as required in the current manual of survey instructions of the United States Department of the Interior, Bureau of Land Management or by a decree of a Court of Law and/or that the corner points mentioned in lines 3, 4 and 5 above were in conformance with the rules of the Michigan Board of Land Surveyors or by a Decree of a Court of Law; established, re-established, monumented, recovered, found as expressed below:

NOTE: Not more than 2 corners, all in the same town and range, may be recorded on this certificate.

A. Description of original monument and accessories and/or subsequent restoration:


- ORIGINAL POST SET BY LUCIUS LYON D.S. FEB. 1825 WITH THE FOLLOWING WITNESSES.  
 W.O. 16" S64E 99(65.3')  
 DO. 33" N46W 92(60.7')
- IN JUNE 1886 JOHN HOLCROFT REPORTED: "FOUND OLD STAKE AND REMAINS OF 2ND WITNESS." AND RECORDED TWO WITNESSES AS:  
 Y. OAK 15" N82E 257(169.6')  
 DO. 15" N80-3/4W 269(177.5')

B. Description of corner evidence found and/or method applied in restoring or reestablishing corner:

SEARCHED AT APPARENT LOCATION OF CORNER AND FOUND 20D SPIKE 2' SOUTH OF CENTERLINE GRAND RIVER RD. MATCHING HOLCROFT'S OAK WITNESS TO THE NORTHEAST. EXCAVATED 2' DIAMETER HOLE. FOUND NOTHING MORE. FOUND REMAINS OF HOLCROFT'S 2<sup>ND</sup> WITNESSES AND IT ALSO MEASURES GOOD TO NAIL. EXPANDED HOLE TO 4' DIAMETER INTO NATURAL GROUND. FOUND NOTHING MORE. AT THIS TIME BELIEVED THAT FIRECLAY HAD BEEN DESTROYED BY ABOUT A 2.5' ROAD CUT. ACCEPTED NAIL AS PERPETUATION OF CORNER AND SET CAST IRON HARRISON MONUMENT. TRAVERSE OF SECTION CONVINCED ME THAT CORNER SHOULD BE FURTHER NORTH. RETURNED MAY 12 WITH ROAD COMMISSION BACKHOE AND EXCAVATED HOLE 4' NORTH AND SOUTH BY 6' EAST AND WEST JUST NORTH OF CENTERLINE GRAND RIVER RD. FOUND BOTTOM 10" OF FIRECLAY IN LIME DEPOSIT. BELIEVED REMAINDER OF FIRECLAY WAS DESTROYED IN ROAD CUT. ACCEPTED FIRECLAY AS PERPETUATION OF CORNER AND MOVED HARRISON MONUMENT TO POSITION OF FIRECLAY.

C. Description of monument for corner and accessories established to perpetuate locating the position of the corner:

- I-5 T1S R2W
  - 4" X 30" CAST IRON HARRISON MONUMENT AND BRASS CAP STAMPED 25837.
  - NAIL AND TAG 28409 SOUTH SIDE 36" OAK, NAZ 86°, 170.14'
  - NAIL AND TAG 28409 NORTH SIDE 36" OAK, NAZ 104°, 175.15'
  - NAIL AND TAG 28409 WEST SIDE 8" OAK, NAZ 198°, 30.55'
  - NAIL AND TAG 28409 NORTH SIDE 15" WALNUT, NAZ 262°, 75.35'
  - NAIL AND TAG 28409 EAST SIDE 17" CEDAR, NAZ 351°, 44.65'
  - NAIL AND SHINER 20707 IN EAST SIDE R.R. TIE FENCE POST, NAZ 4°, 27.56'
  - SURVEY MARKER SIGN, NAZ 183°, 23.9'
- Signed by David L. Clifford Date JULY 8, 1997  
 Surveyor's Michigan License No. 25837

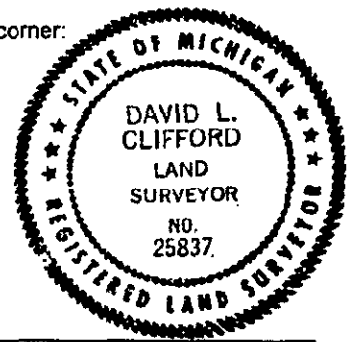

00000 957